



WASATCH COUNTY INTERLAKEN MUTAL WATER COMPANY 2003 WATERLINE IMPROVEMENTS RECORD DRAWINGS - LUZERN DRIVE
 SOWBY & BEPC CONSULTANTS 15 N. 490 W. #42-277 AMERICAN FORK, UTAH 84003
 SCALE: 1" = 50'
 DESIGN BY: SES DATE: 02 APR 2003 DRAWING NAME: #01 SHEET NO. W1
 DRAWN BY: RDB REV: 24 NOV 2004

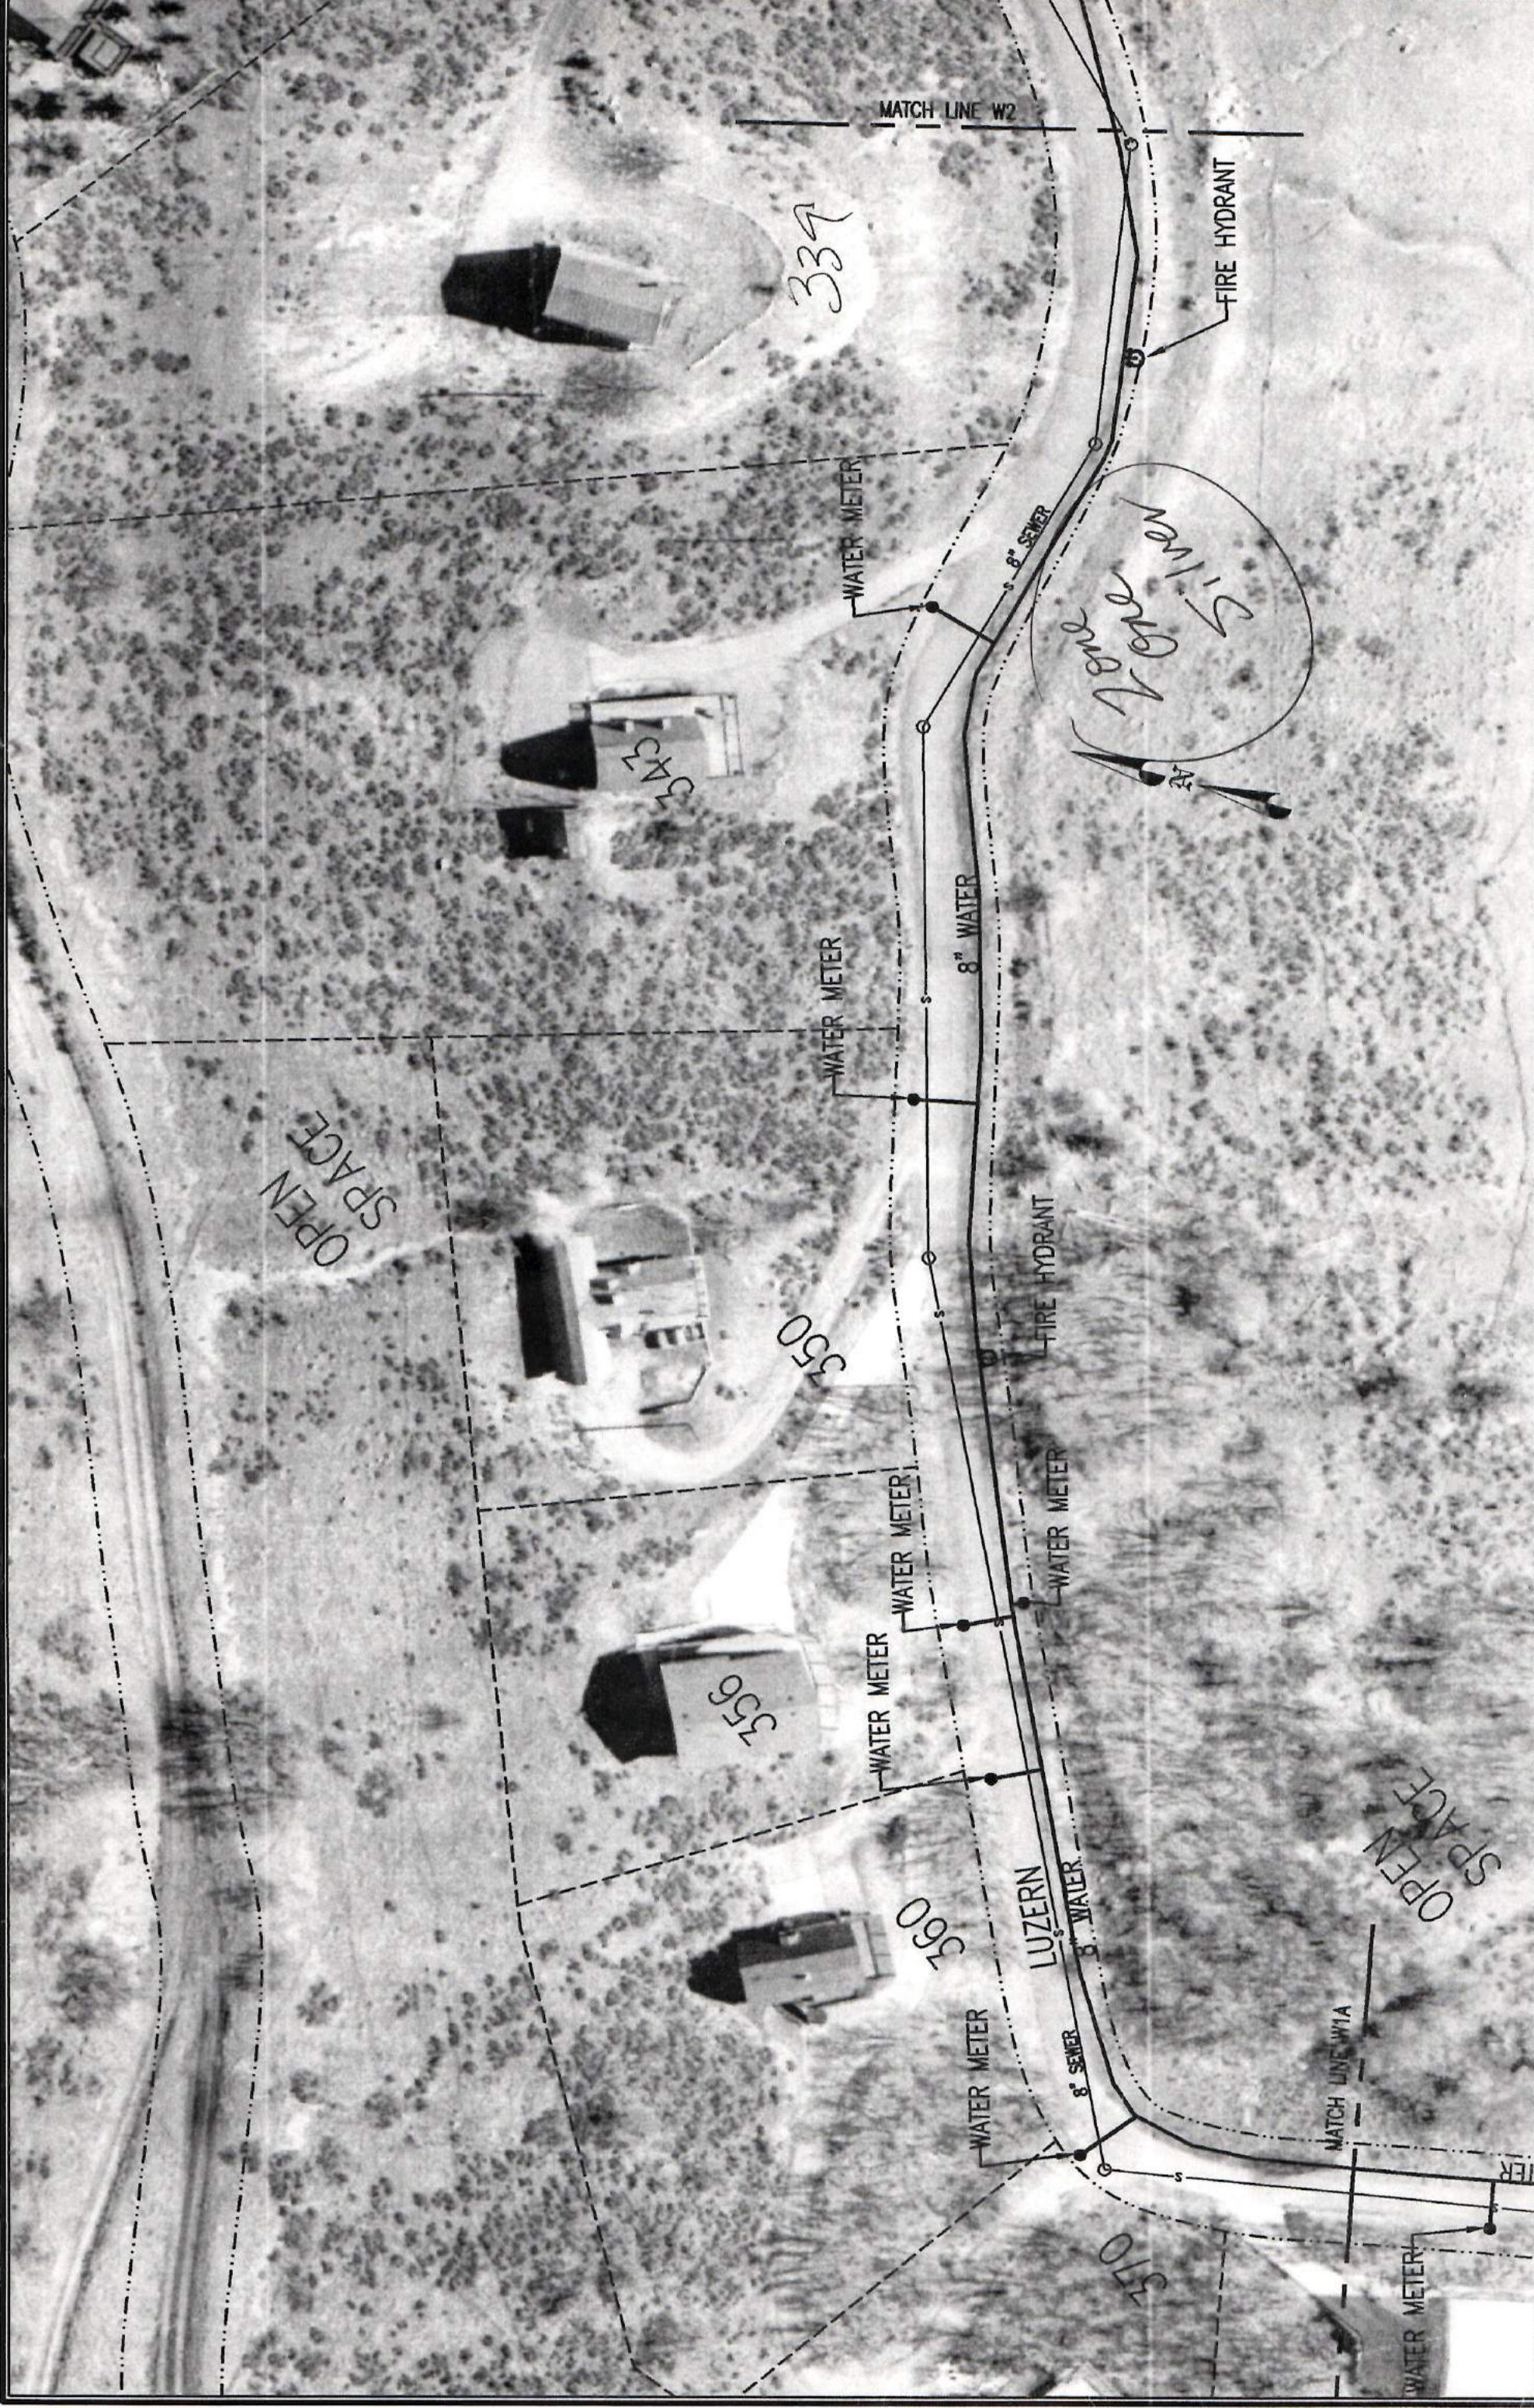

WASATCH COUNTY	INTERLAKEN MUTAL WATER COMPANY	2003 WATERLINE IMPROVEMENTS RECORD DRAWINGS - LUZERN DRIVE	SOWBY & BERG CONSULTANTS 45 N. 450 W. 492-1277 AMERICAN FORK, UTAH 84003	SCALE: 1" = 50'	DESIGN BY: SES DRAWN BY: RDB	DATE: 02 APR 2003 REV: 23 NOV 2004	DRAWING NAME: W01A	SHEET NO. W1A
----------------	--------------------------------	--	--	--------------------	---------------------------------	---------------------------------------	-----------------------	------------------

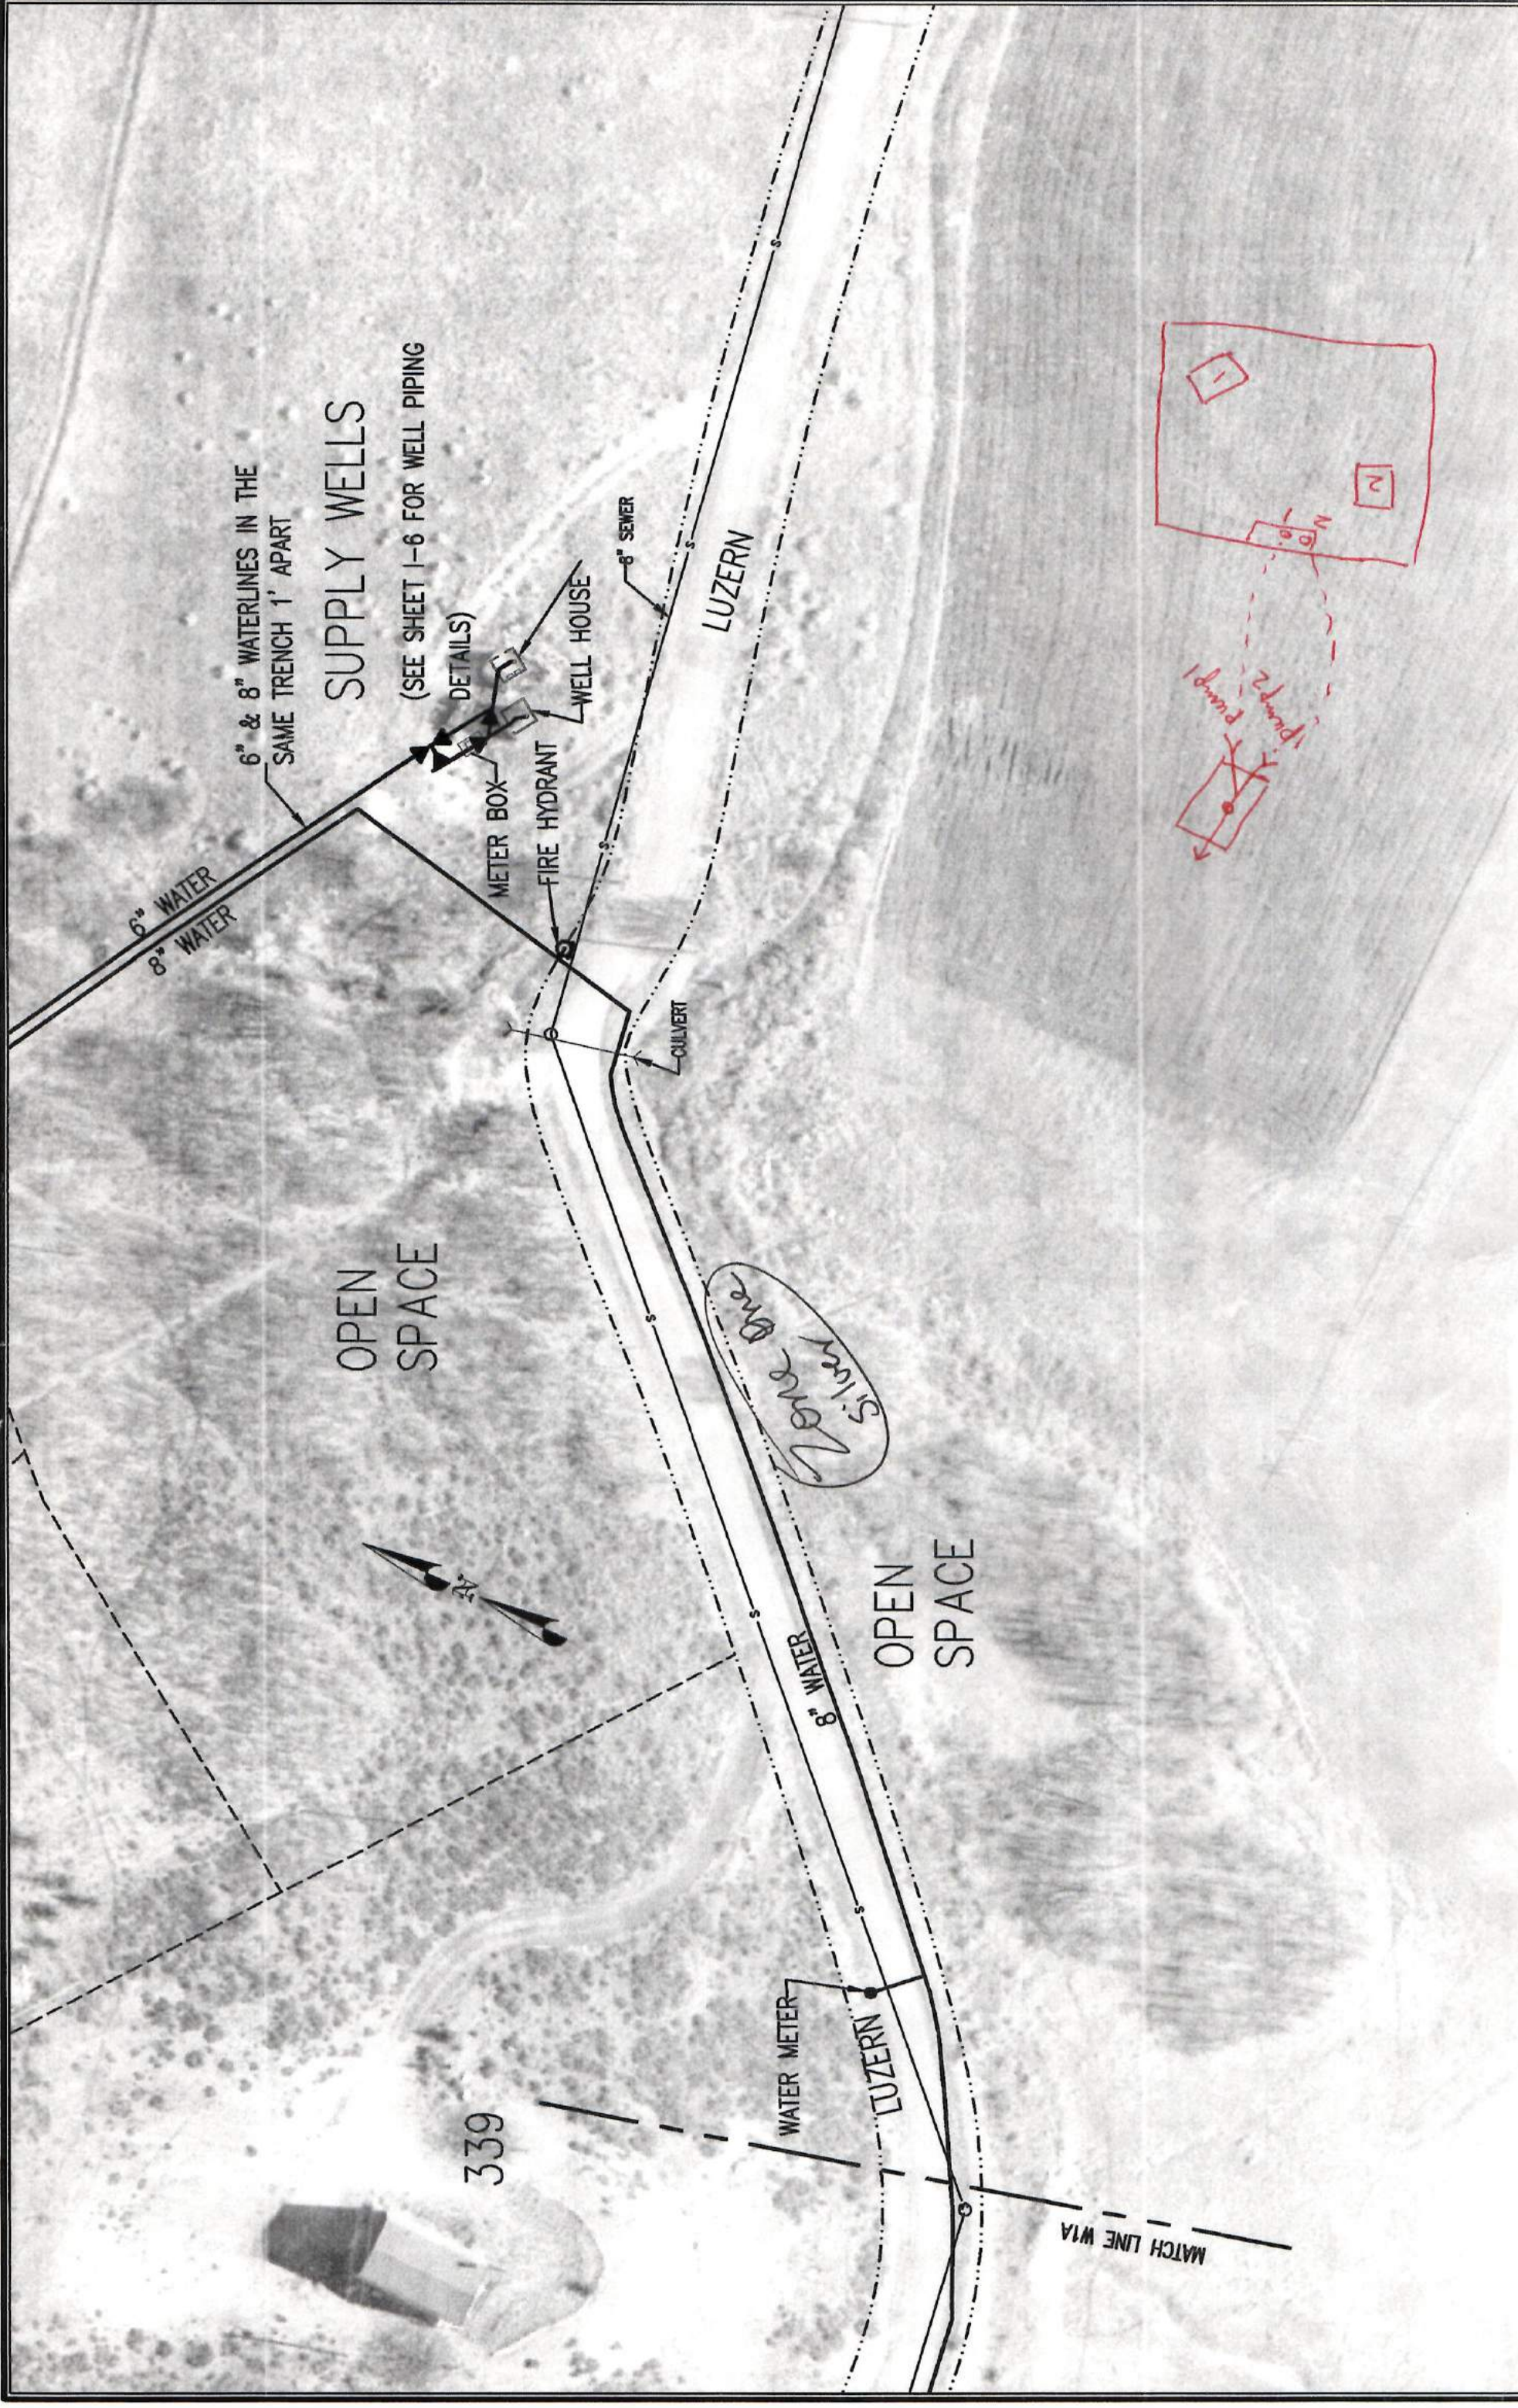

6" & 8" WATERLINES IN THE SAME TRENCH 1' APART

SUPPLY WELLS

(SEE SHEET 1-6 FOR WELL PIPING DETAILS)

METER BOX

FIRE HYDRANT


WELL HOUSE

8" SEWER

OPEN SPACE

OPEN SPACE

Silver One

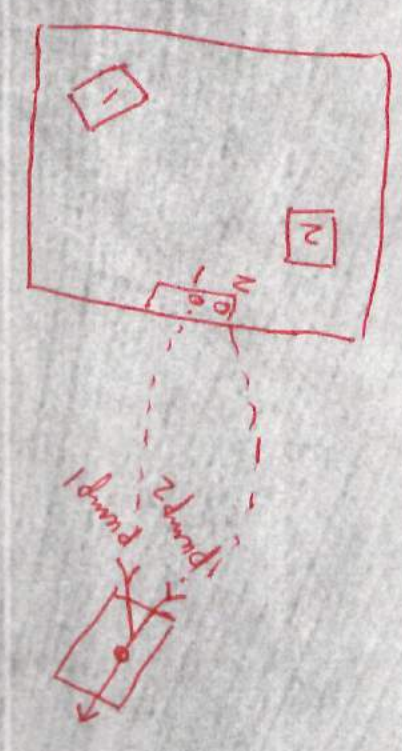





Jump from


Shut's off

6" & 8" WATERLINES IN SAME TRENCH 1' APART

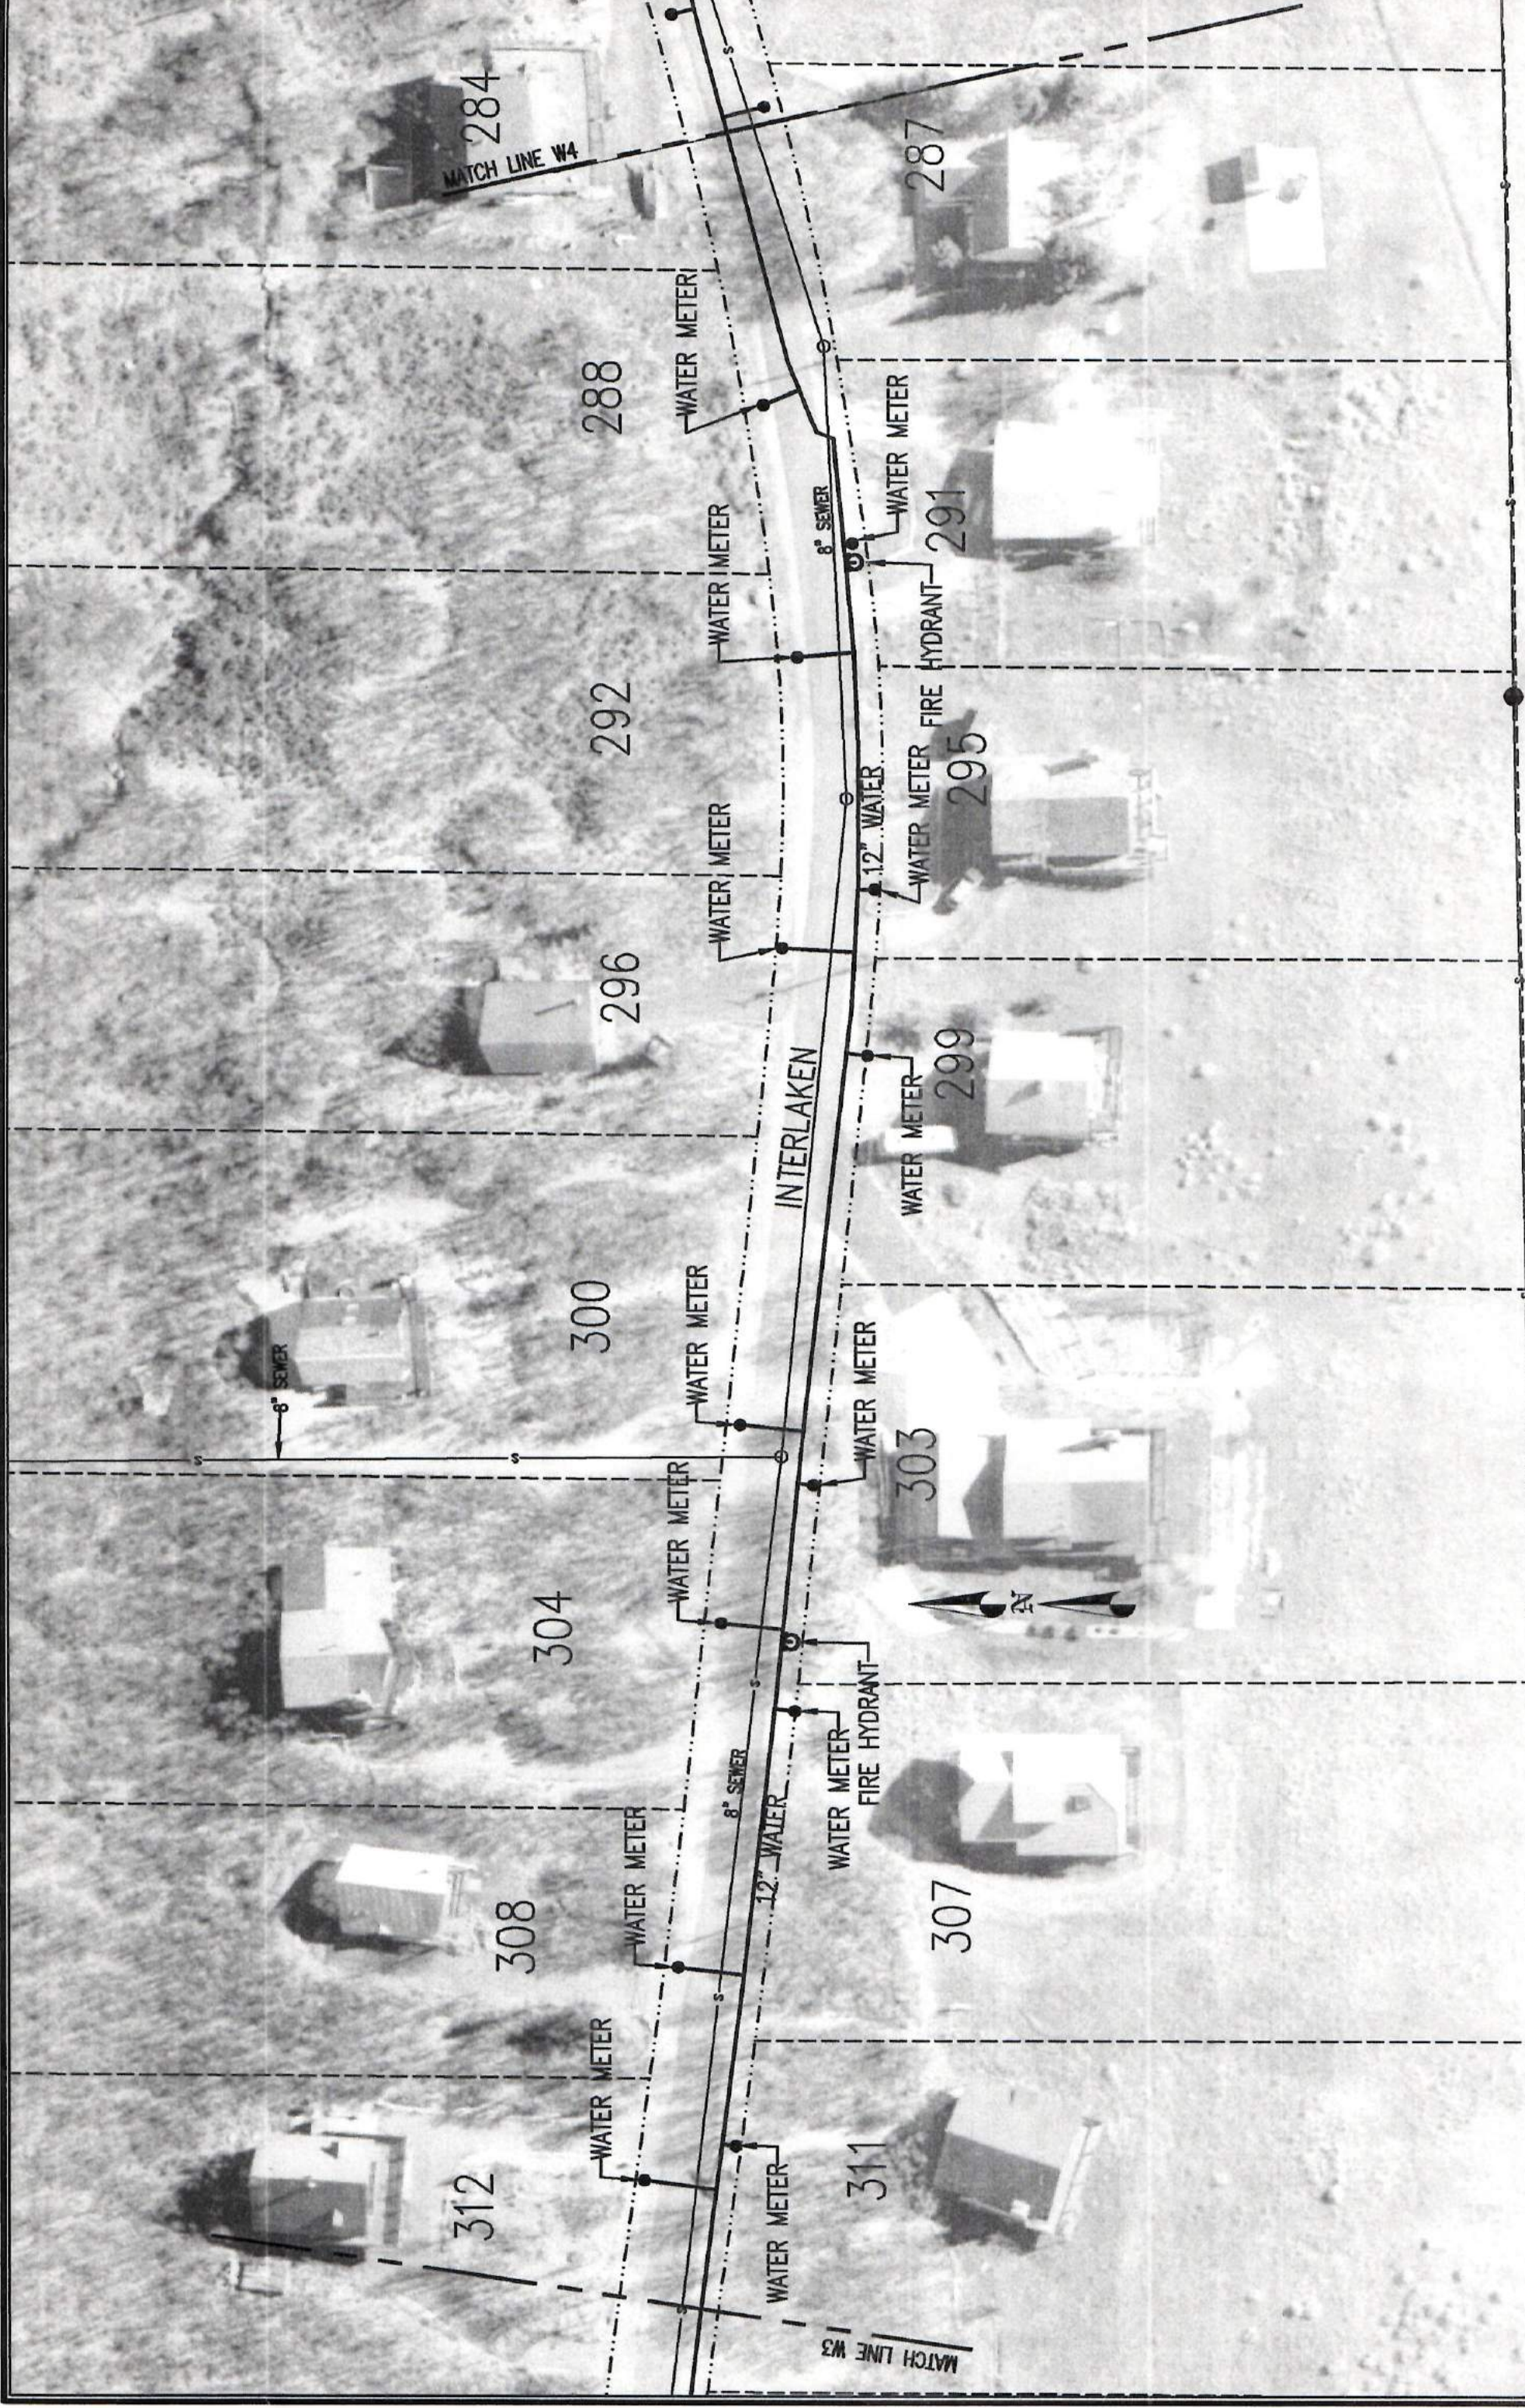

WASATCH COUNTY	INTERLAKEN MUTAL WATER COMPANY	2003 WATERLINE IMPROVEMENT RECORD DRAWING-INTERLAKEN DRIVE	SOWBY & BERG CONSULTANTS 45 N. 490 W. AMERICAN FORK, UTAH 84003	SCALE: 1" = 50'	DESIGN BY: SES DRAWN BY: RDB	DATE: 02 APR 2003 REV: 23 NOV 2004	DRAWING NAME: #3A	SHEET NO. W3A
----------------	--------------------------------	--	---	--------------------	---------------------------------	---------------------------------------	----------------------	------------------

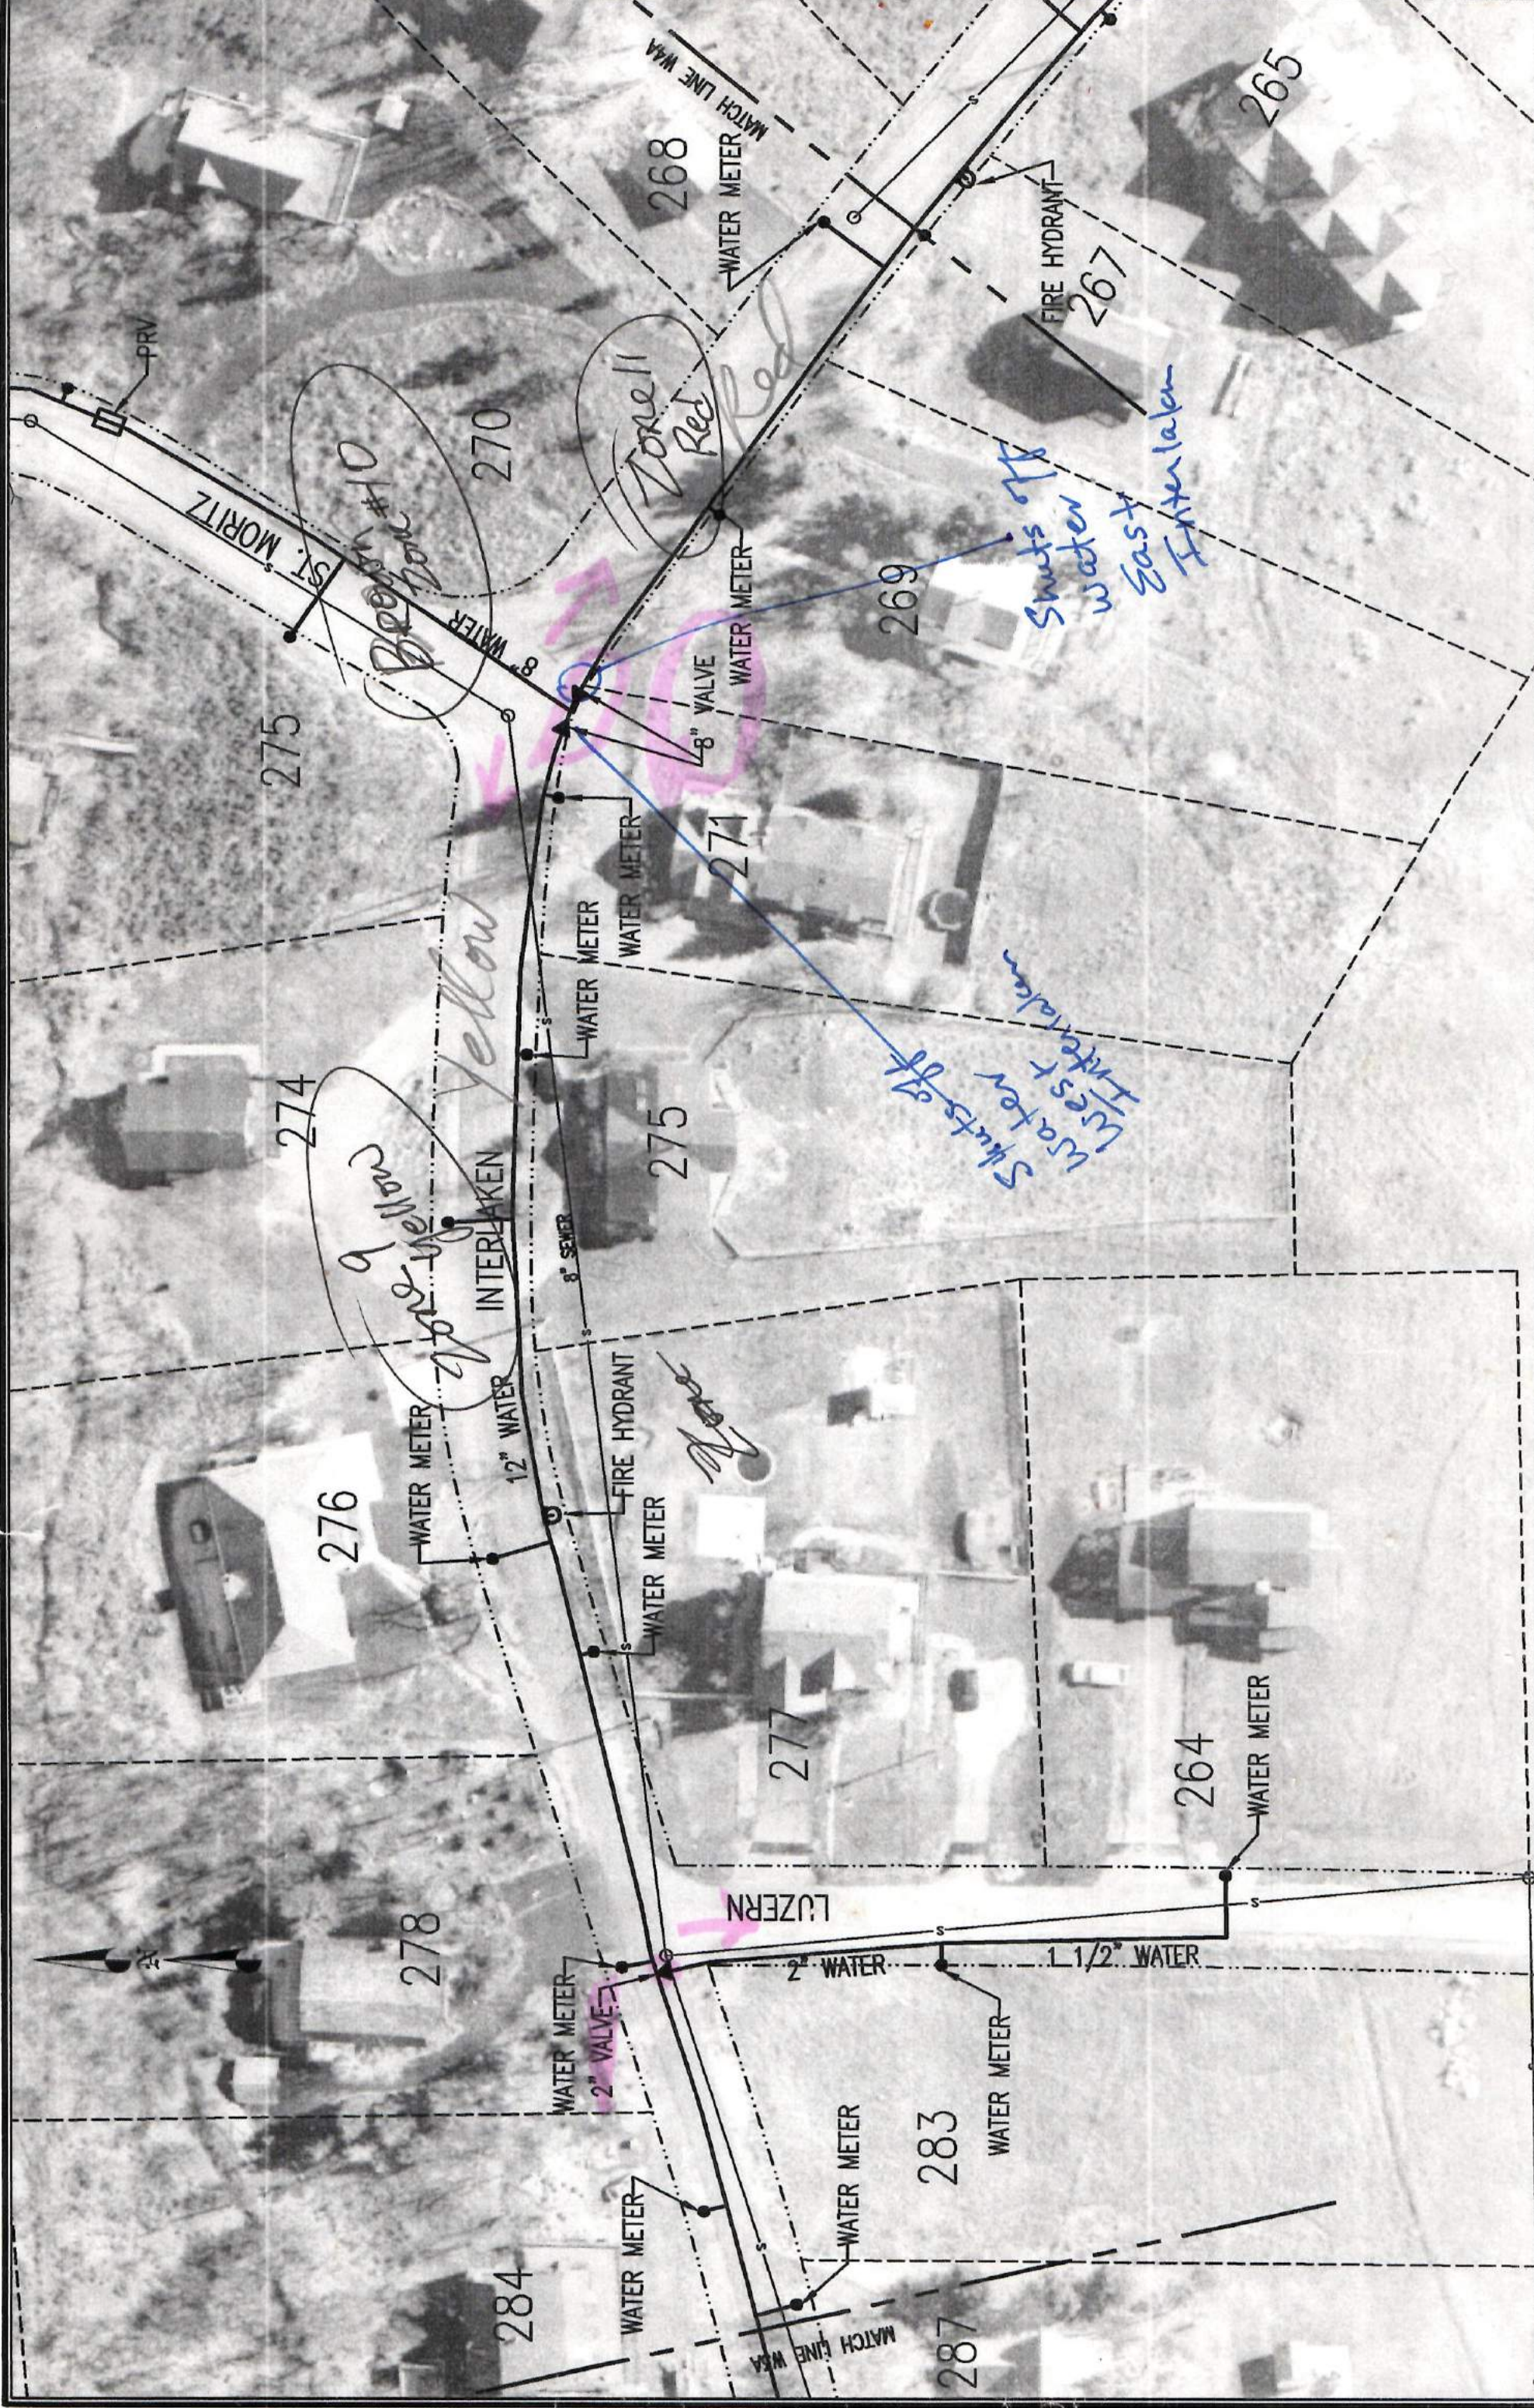

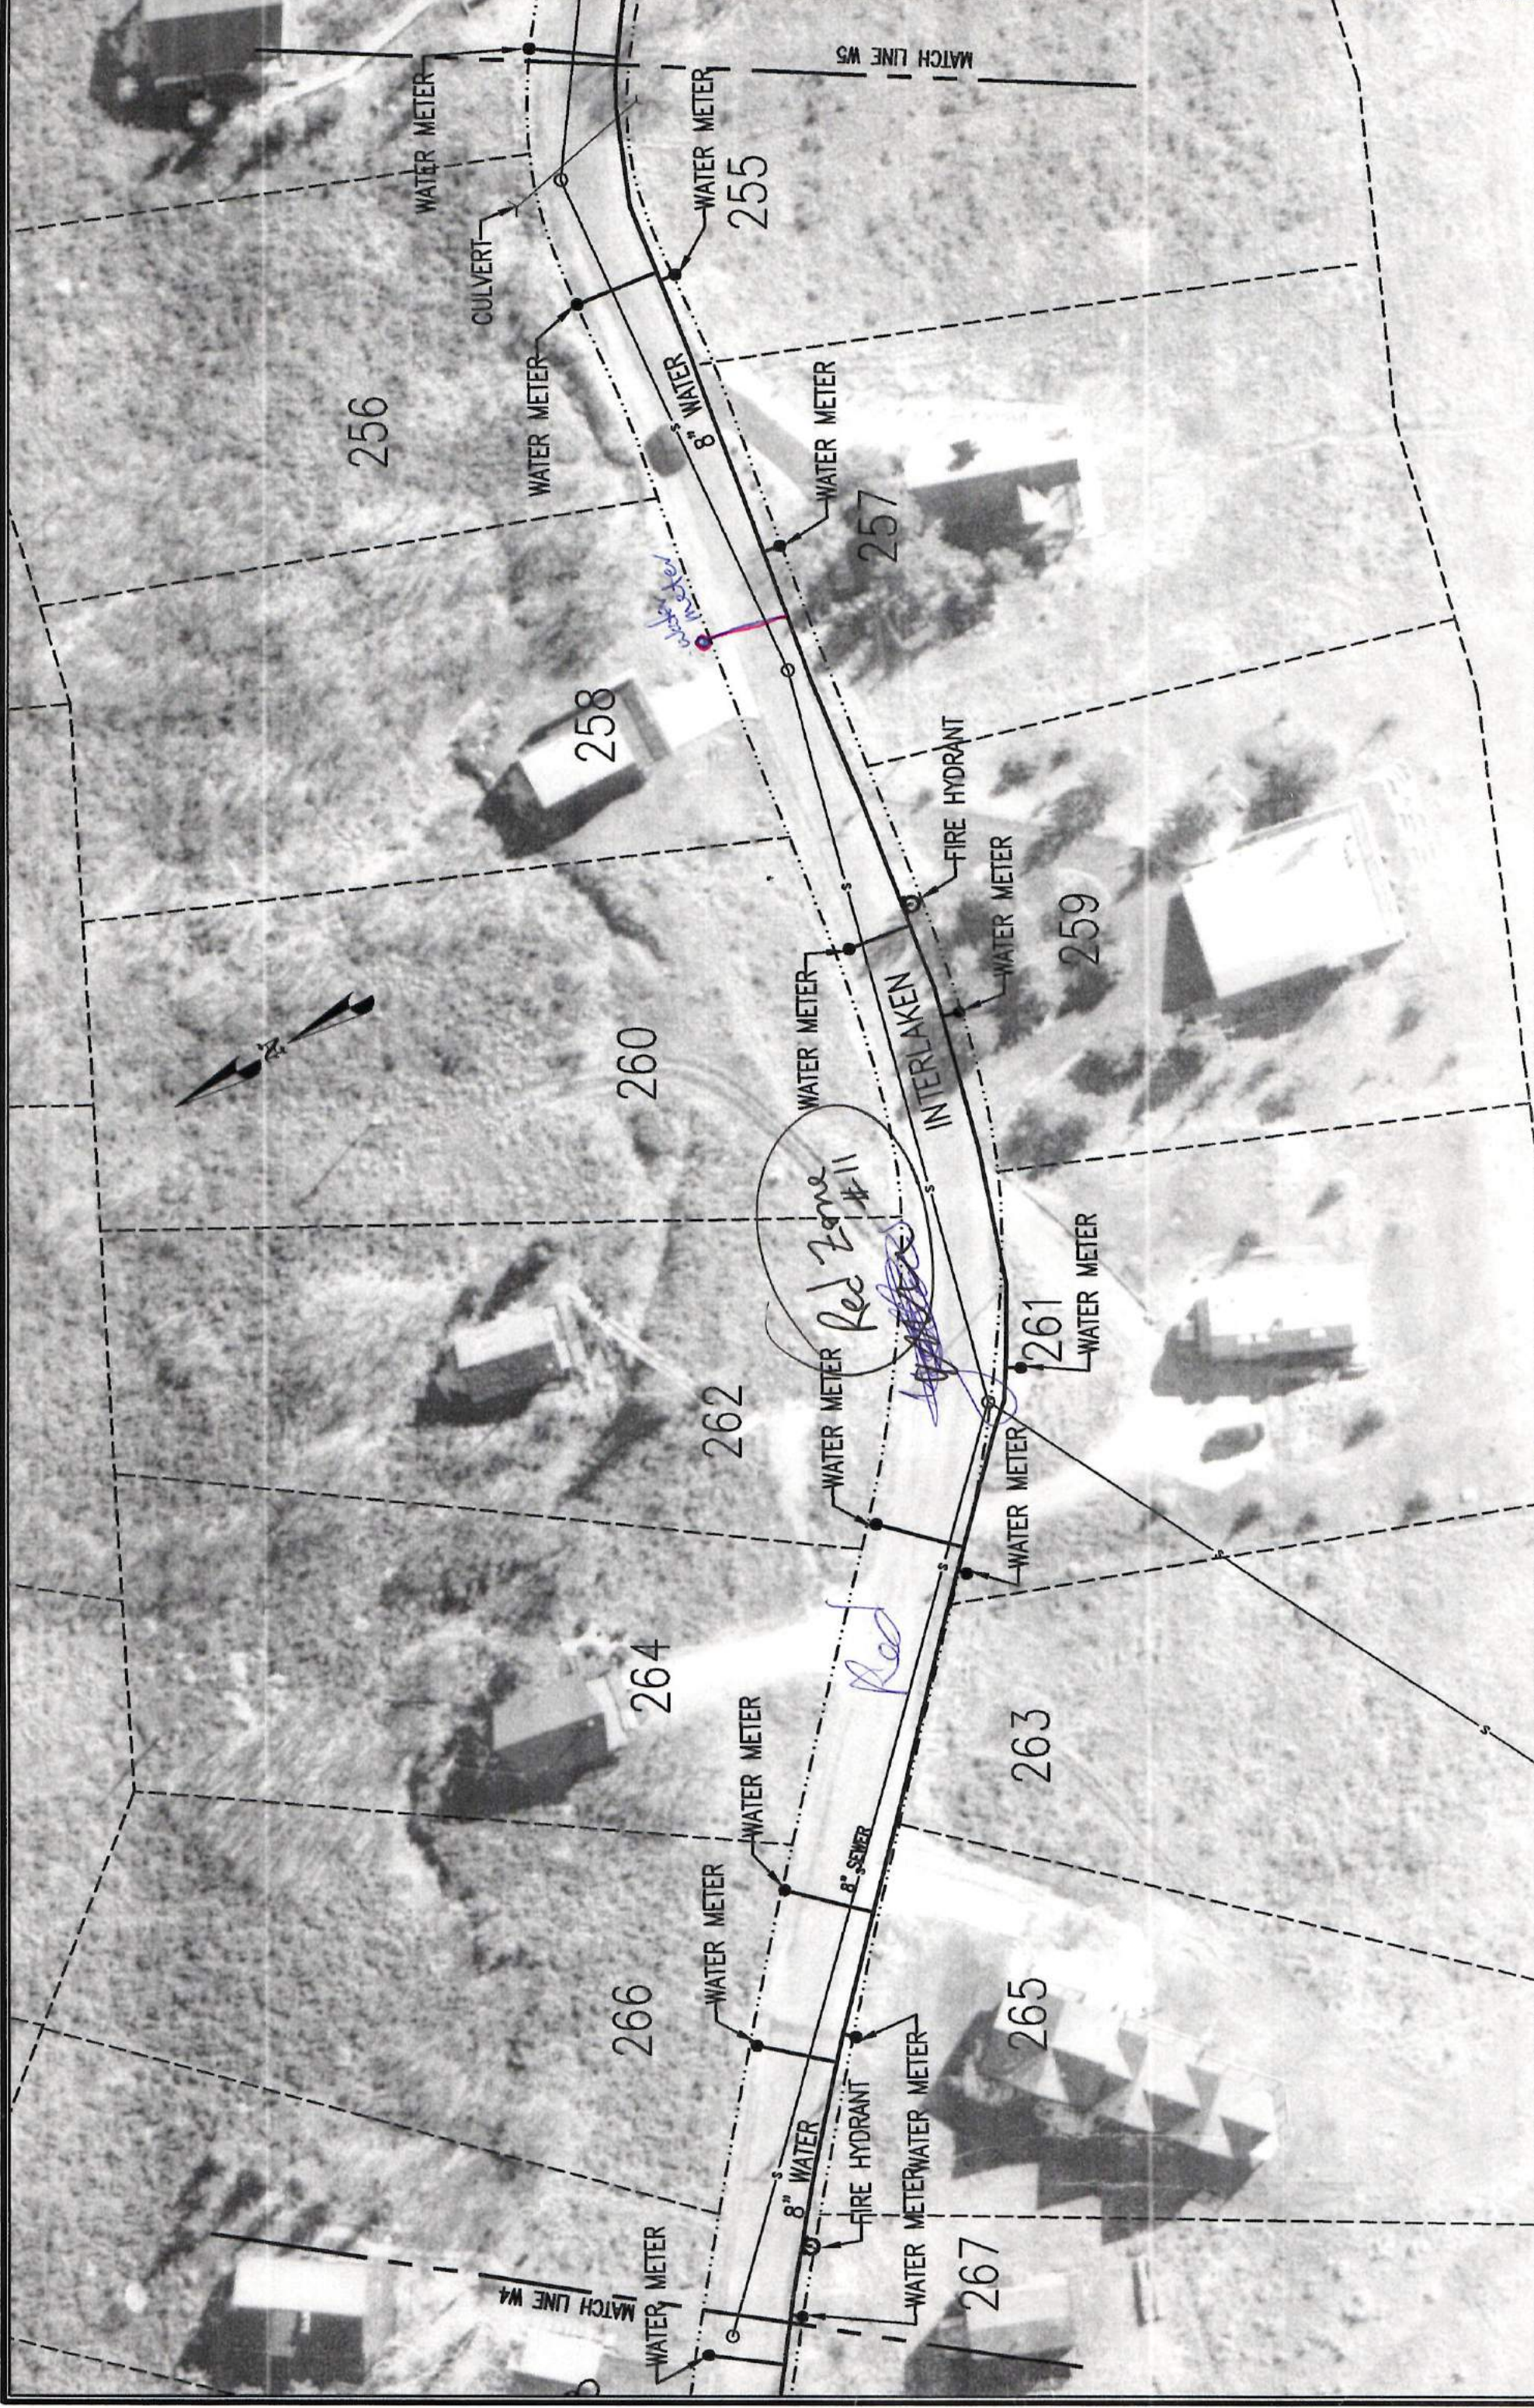


WASATCH COUNTY
 INTERLAKEN MUTAL WATER COMPANY
 2003 WATERLINE IMPROVEMENTS RECORD DRAWINGS-INTERLAKEN DRIVE
 SOWBY & BERG CONSULTANTS
 45 N. 490 W. #492-1277
 AMERICAN FORK, UTAH 84003
 SCALE: 1" = 50'
 DESIGN BY: SES DATE: 02 APR 2003
 DRAWN BY: RDB REV: 23 NOV 2004
 DRAWING NAME: W4A
 SHEET NO: W4A



WASATCH COUNTY
 INTERLAKEN MUTAL WATER COMPANY
 2003 WATERLINE IMPROVEMENTS RECORD DRAWINGS-INTERLAKEN DRIVE
 SOWBY & BERG CONSULTANTS
 45 N. 450 W. #492-1277
 AMERICAN FORK, UTAH 84003
 SCALE: 1" = 50'
 DESIGN BY: SES DATE: 02 APR 2003
 DRAWN BY: RDB REV: 23 NOV 2004
 DRAWING NAME: #5
 SHEET NO: W5



WASATCH COUNTY	INTERLAKEN MUTAL WATER COMPANY	2003 WATERLINE IMPROVEMENTS RECORD DRAWINGS- BERN WAY	SOWBY & BERG CONSULTANTS 45 N. 490 W. 492-1277 AMERICAN FORK, UTAH 84003	SCALE: 1" = 50'	DESIGN BY: SES DRAWN BY: RDB	DATE: 20 MAR 2003 REV: 23 NOV 2004	DRAWING NAME: W06	SHEET NO: W6
----------------	--------------------------------	---	--	--------------------	---------------------------------	---------------------------------------	----------------------	-----------------

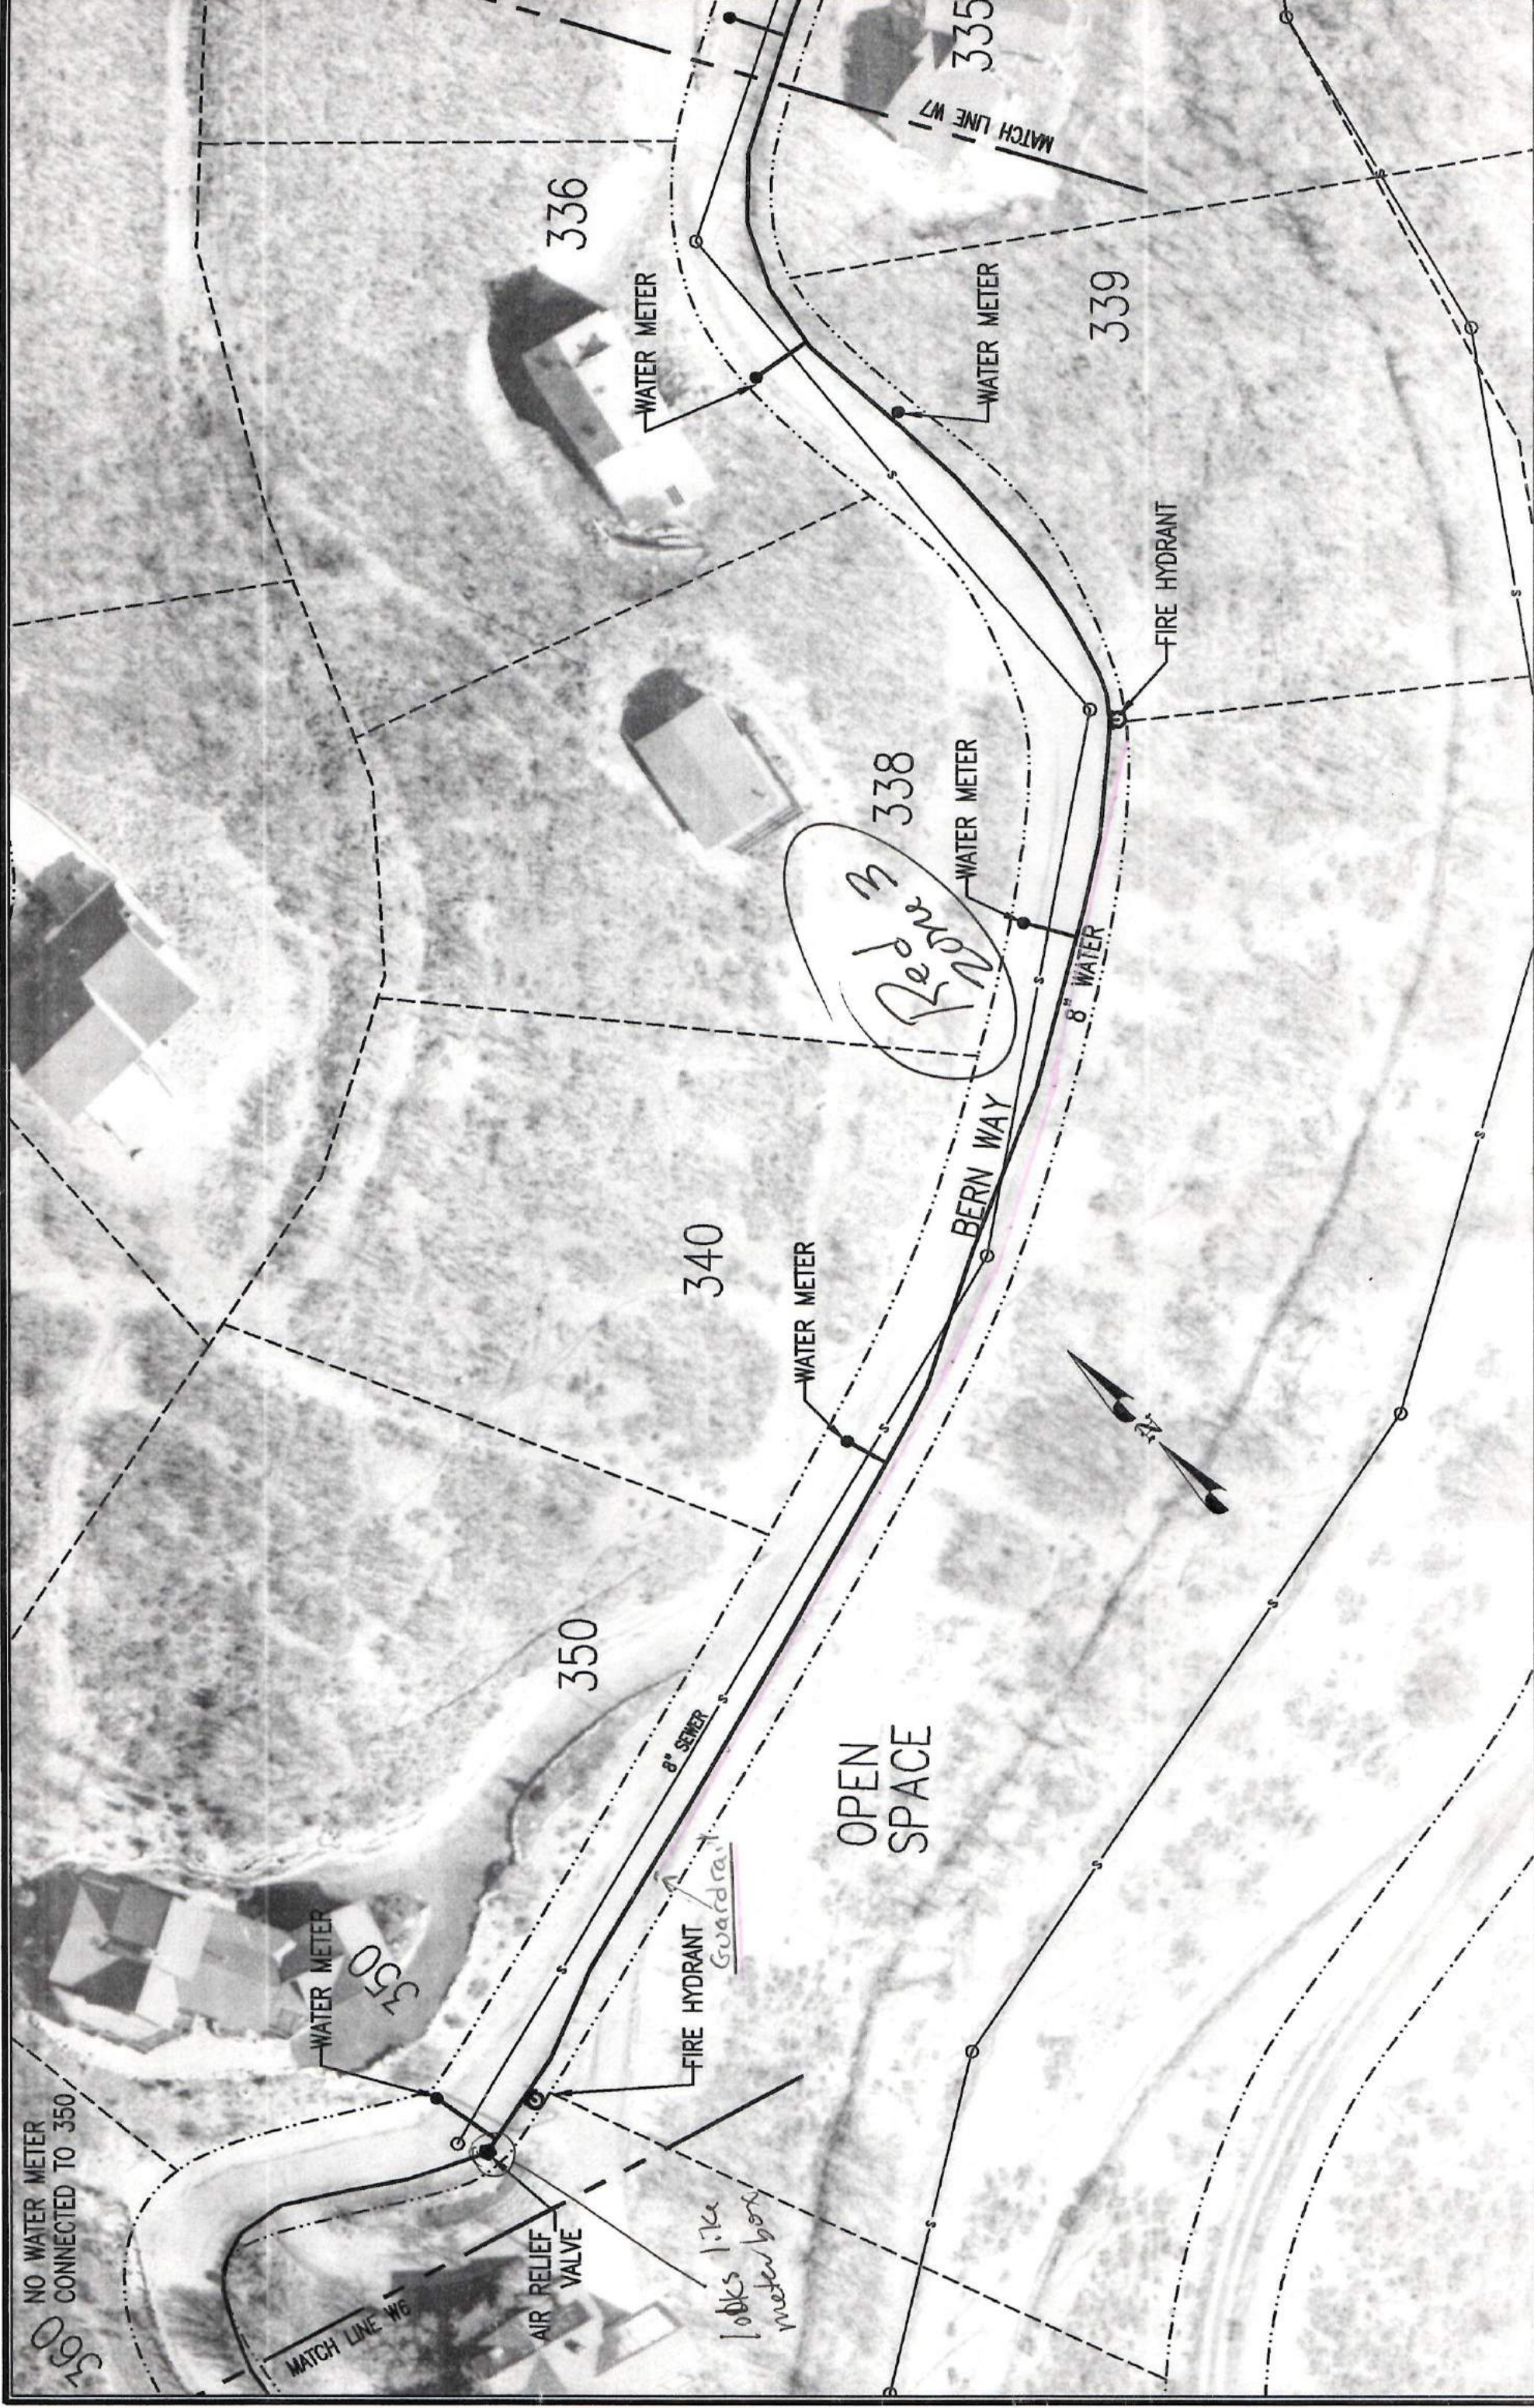

360
NO WATER METER
CONNECTED TO 350

MATCH LINE W6

AIR RELIEF
VALVE

FIRE HYDRANT

8" SEWER

340

WATER METER

OPEN
SPACE

BERN WAY

8" WATER

338

WATER METER

FIRE HYDRANT

339

WATER METER

336

WATER METER


335

MATCH LINE W7


*looks like
meter box*

No pop up

WASATCH COUNTY	INTERLAKEN MUTAL WATER COMPANY	2003 WATERLINE IMPROVEMENTS RECORD DRAWINGS - BERN WAY	SOWBY & BERG CONSULTANTS 46 N. 450 W. AMERICAN FORK, UTAH 84003 492-1277	SCALE: 1" = 50'	DESIGN BY: SES DRAWN BY: RDB	DATE: 20 MAR 2003 REV: 23 NOV 2004	DRAWING NAME: W06A	SHEET NO: W6A
----------------	--------------------------------	--	---	--------------------	---------------------------------	---------------------------------------	-----------------------	------------------

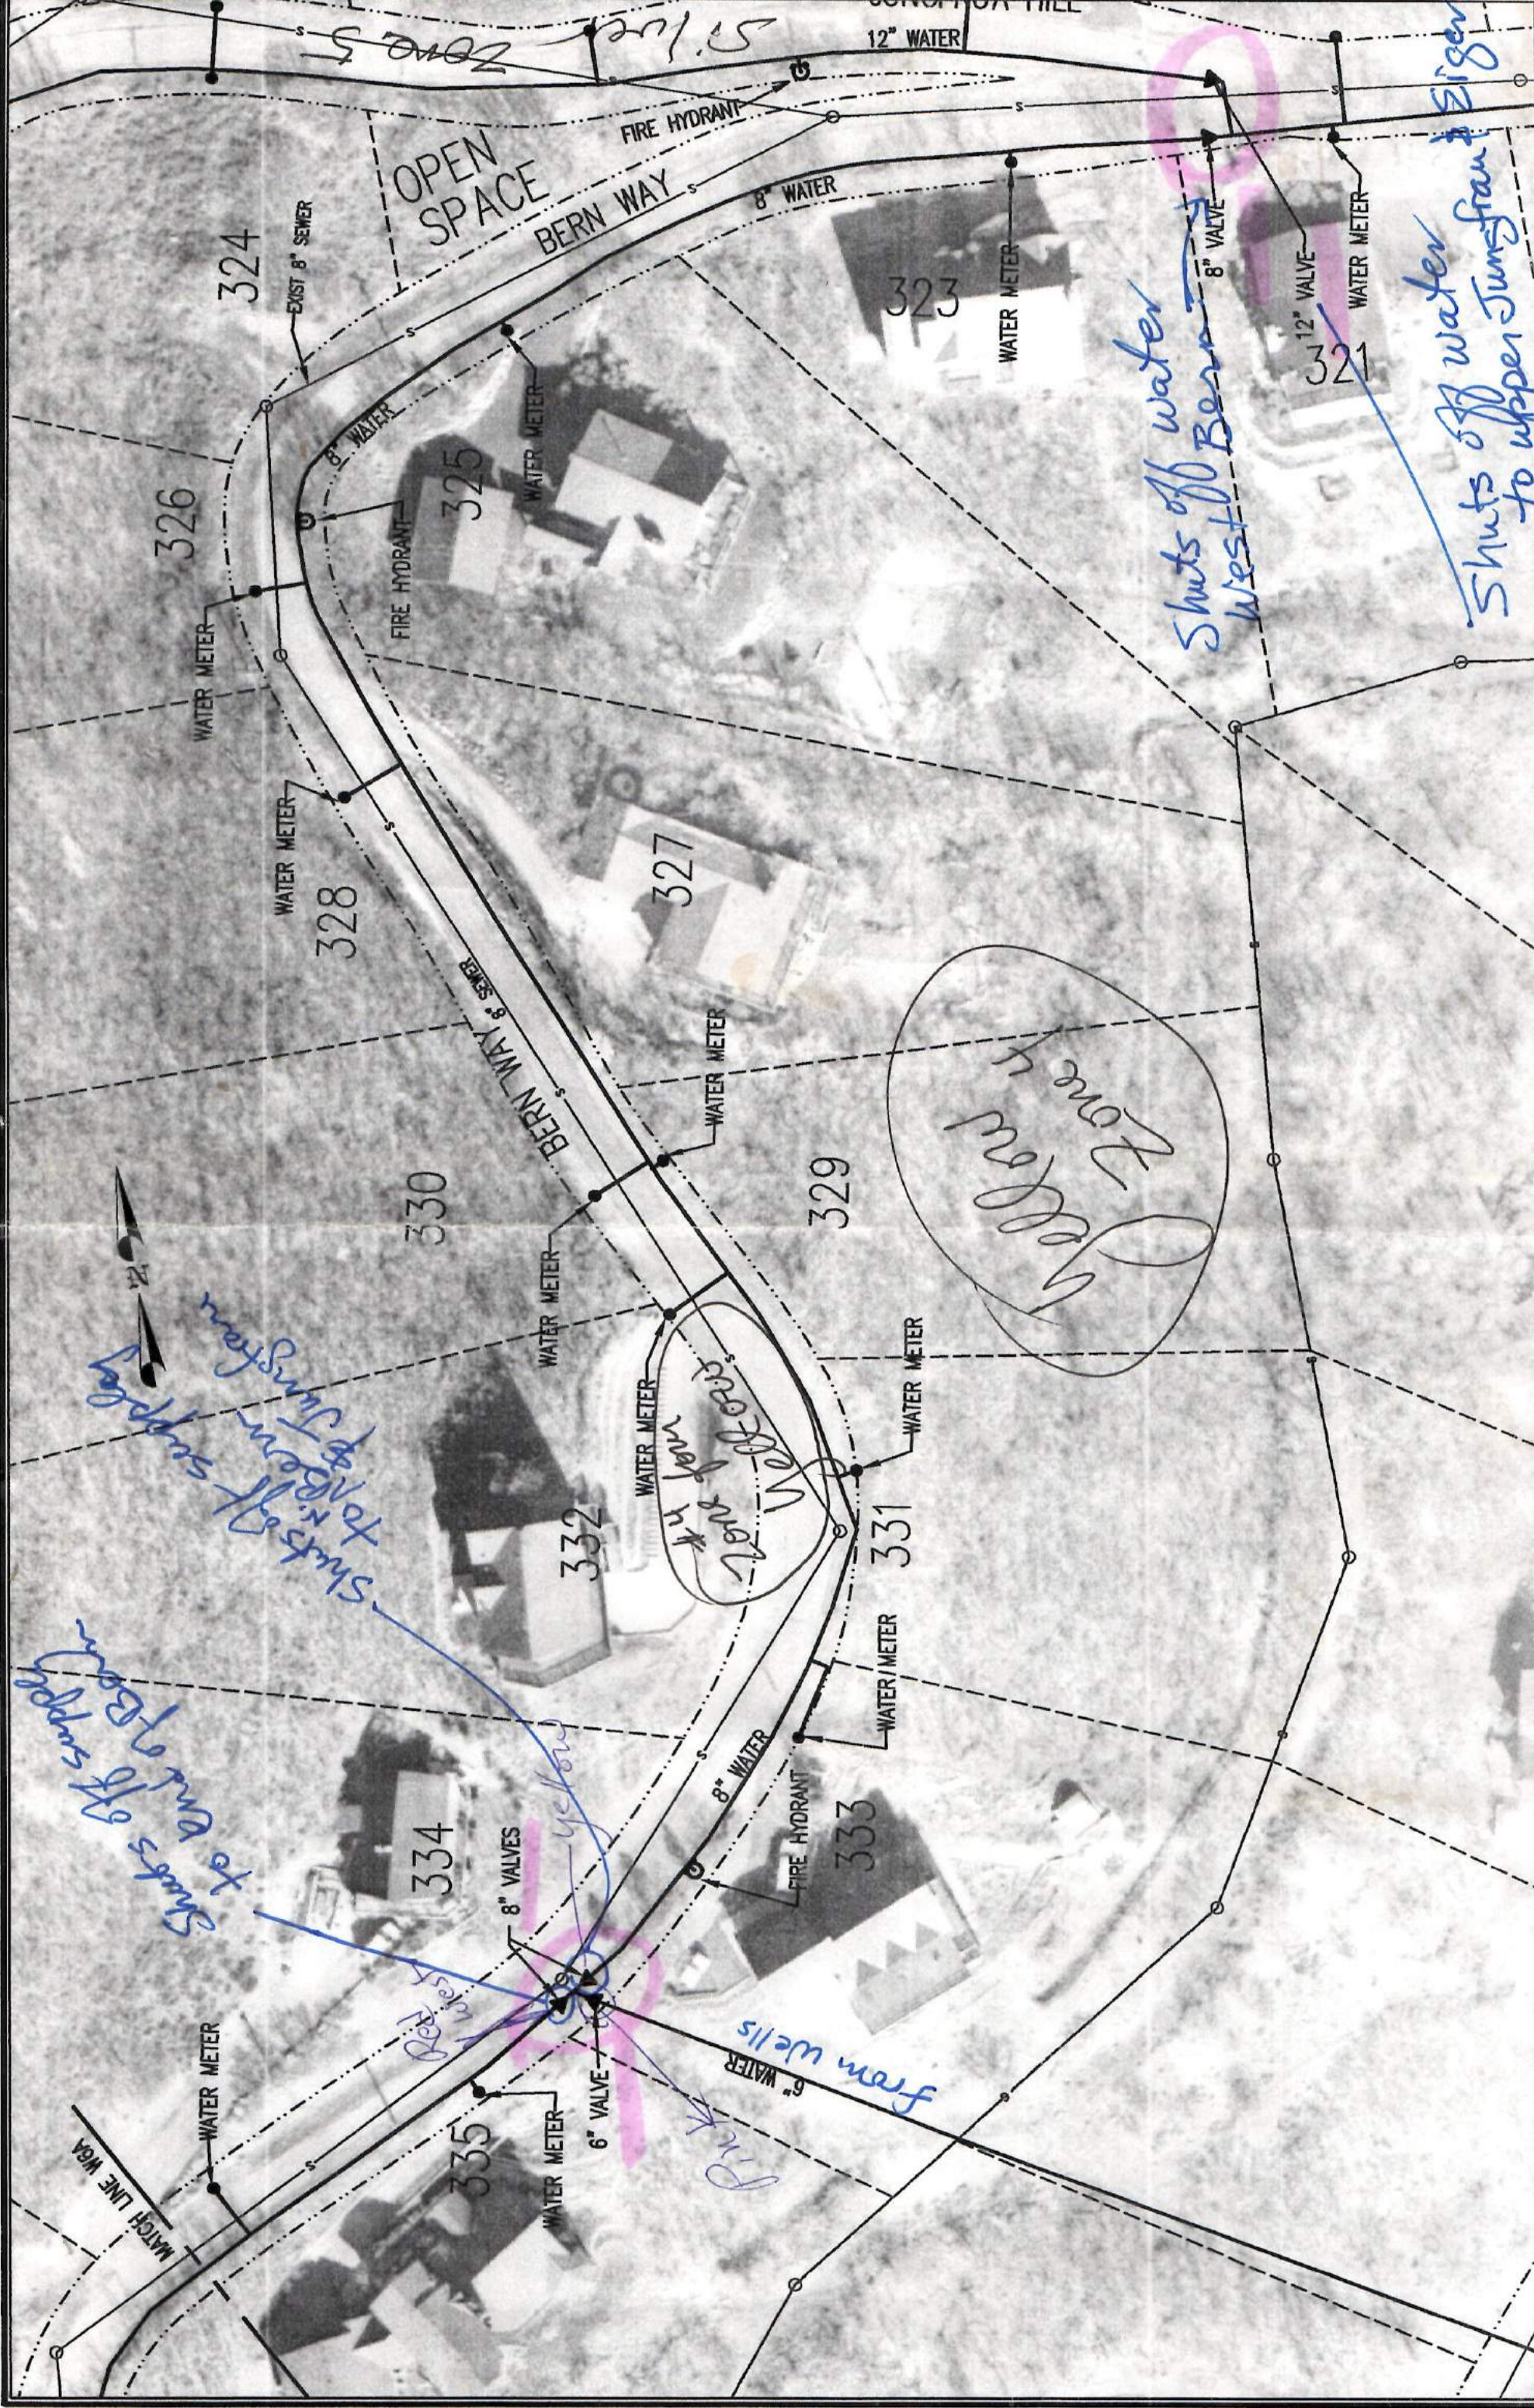

WASATCH COUNTY	INTERLAKEN MUTAL WATER COMPANY	2003 WATERLINE IMPROVEMENTS RECORD DRAWINGS - BERN WAY	SOWBY & BERG CONSULTANTS 45 N. 490 W. #92-1277 AMERICAN FORK, UTAH 84003	SCALE: 1" = 50'	DESIGN BY: SES DRAWN BY: RDB	DATE: 06 APR 2003 REV: 23 NOV 2004	DRAWING NAME: W07	SHEET NO. W7
----------------	--------------------------------	--	--	--------------------	---------------------------------	---------------------------------------	----------------------	-----------------

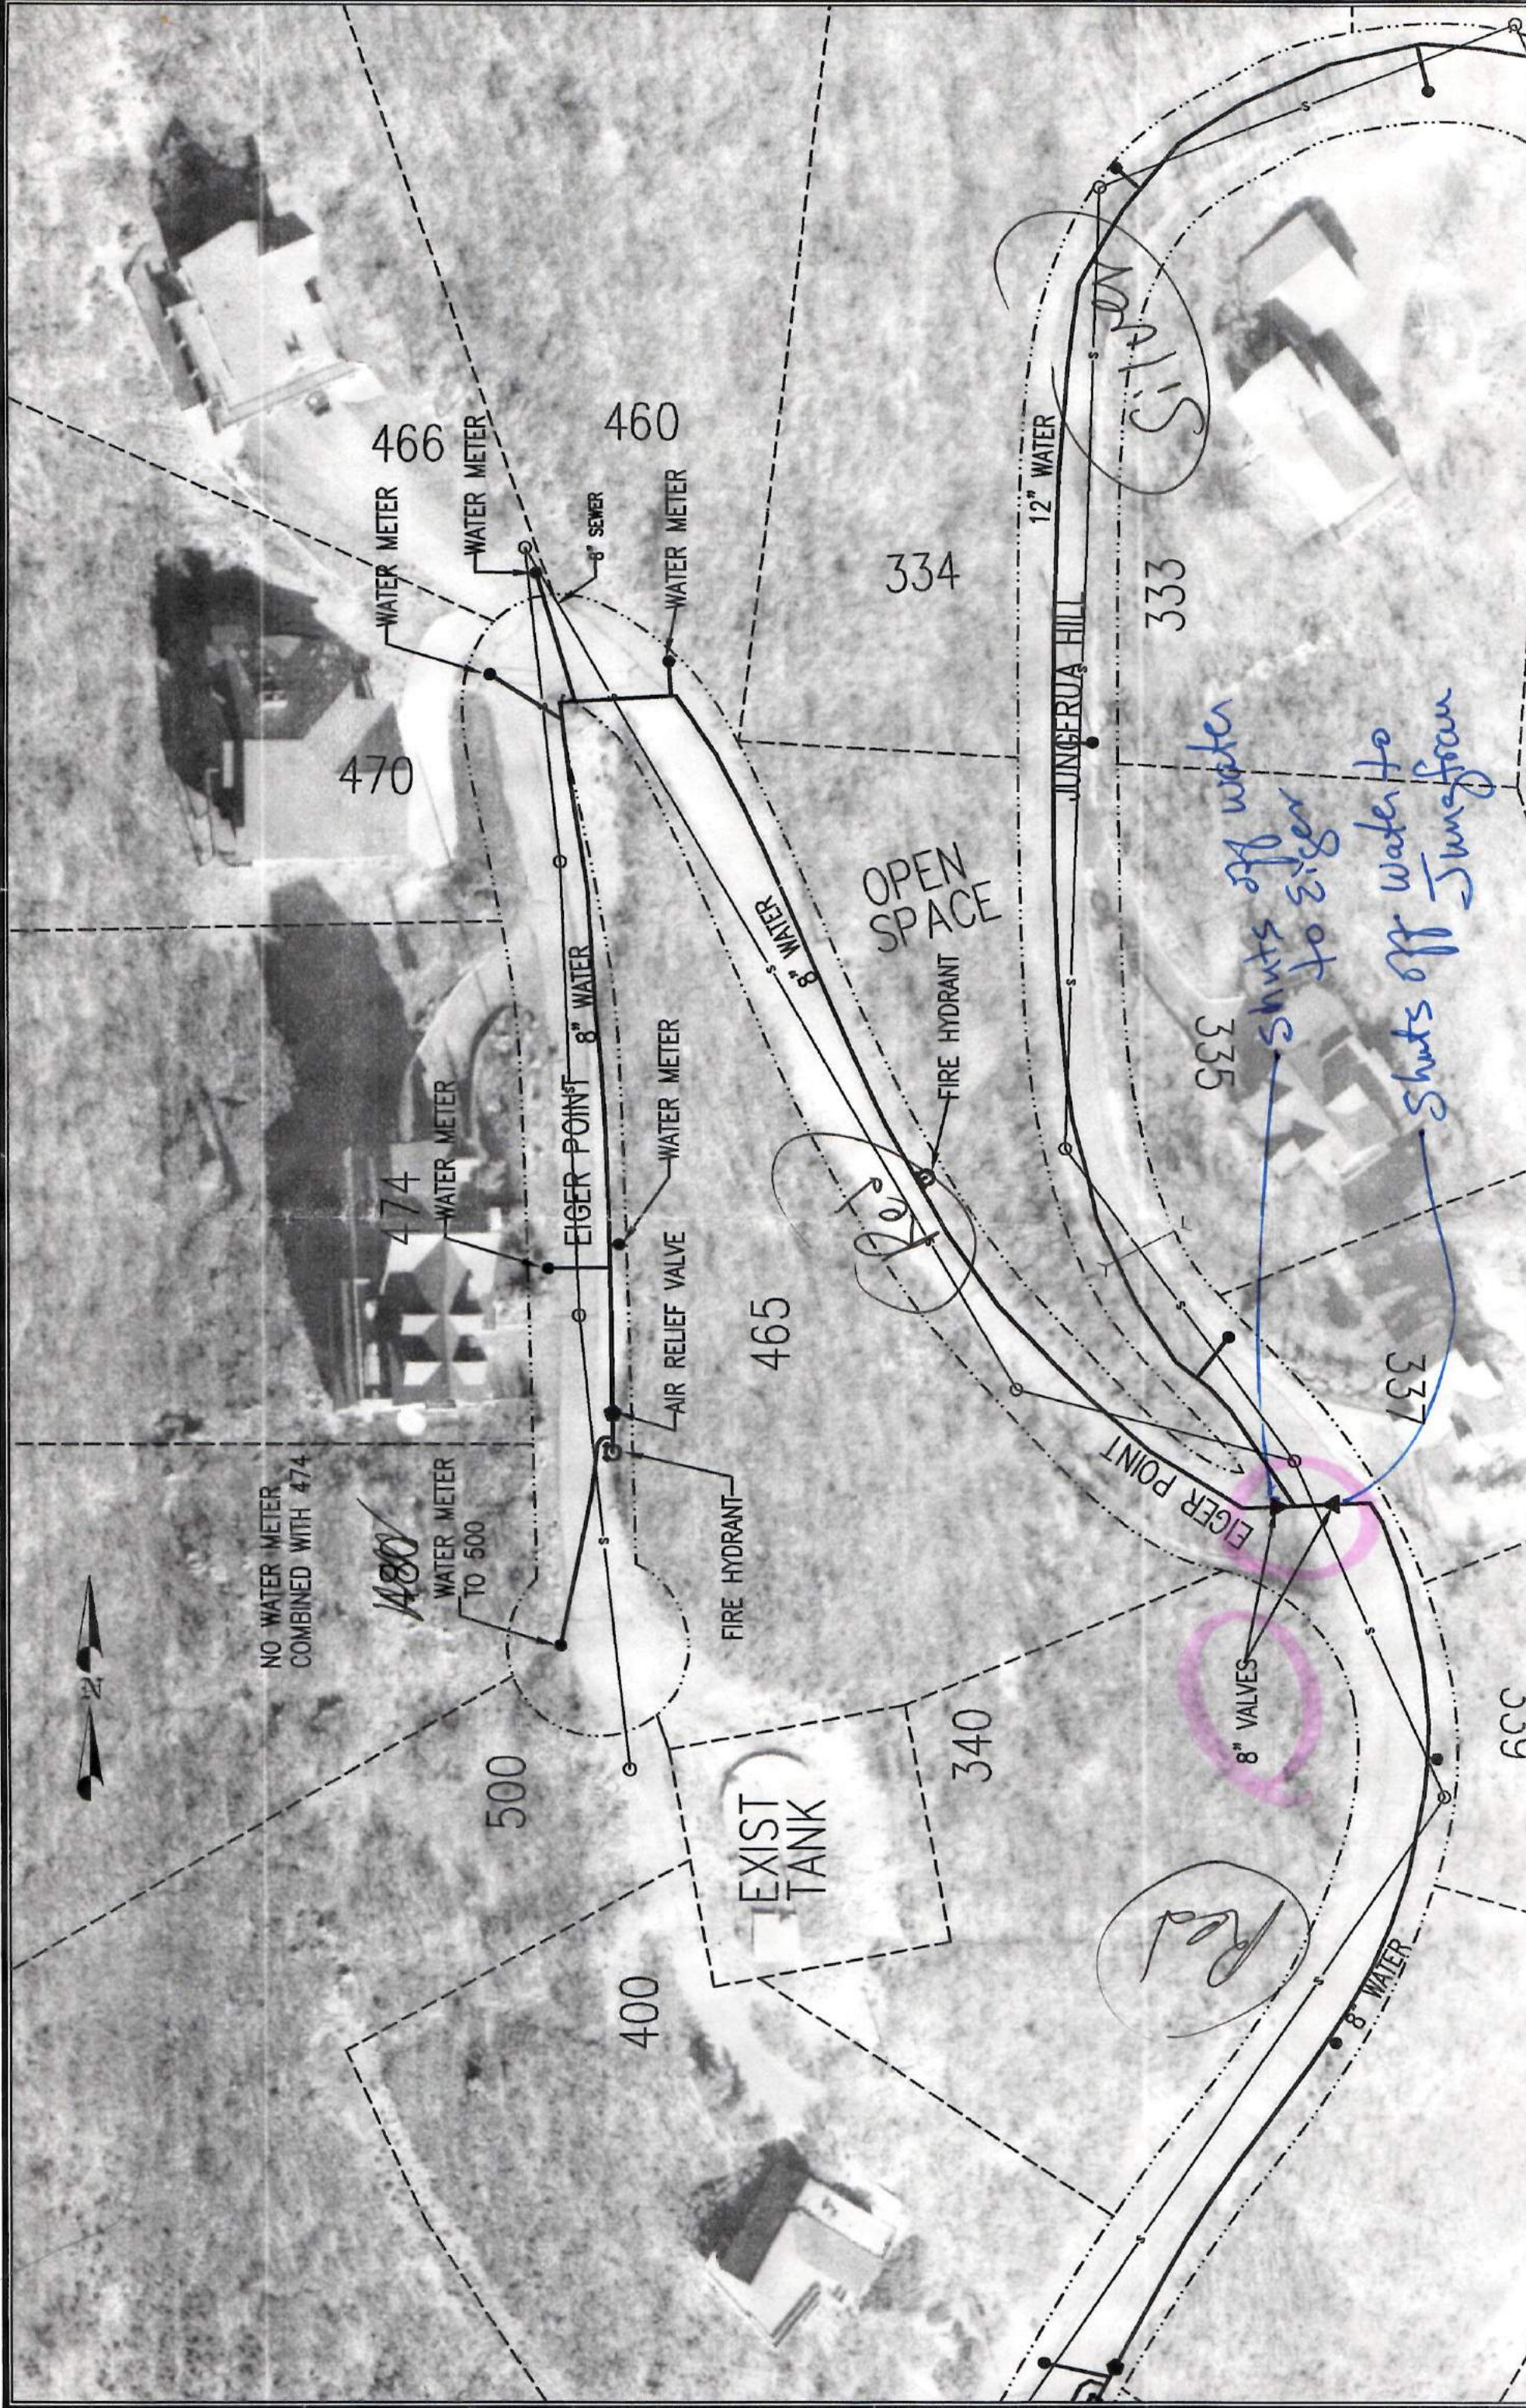

NO WATER METER
COMBINED WITH 474

1480
WATER METER
TO 500

EXIST
TANK

OPEN
SPACE

EIGER POINT

8" VALVES

*Shuts off water
to Eiger*

*Shuts off water to
Jungfrau*

Sitdown

WASATCH COUNTY	INTERLAKEN MUTAL WATER COMPANY	2003 WATERLINE IMPROVEMENTS RECORD DRAWINGS - EIGER POINT	SCALE: 1" = 50'	DESIGN BY: SES DATE: 20 MAR 2003 DRAWN BY: RDB REF: 23 NOV 2004	DRAWING NAME: #08	SHEET NO: WB
----------------	--------------------------------	---	-----------------	--	-------------------	--------------

SOWBY & BERG CONSULTANTS
45 N. 490 W. 492-1277
AMERICAN FORK, UTAH 84003



OPEN SPACE

465

EXIST TANK

500

455

400

425

WATER METER

1.5" WATER

2" WATER

JUNGFRAU HILL

WATER METER

FIRE HYDRANT

345

WATER METER

8" WATER

AIR RELIEF VALVE

340

8" VALVES

No Meter here

339

WATER METER

EXIST 8" SEWER

337

WATER METER

335

CULVERT

8" WATER

EIGER POINT

12" WATER

FIRE HYDRANT

333

WATER METER

MATCH LINE W9A

JUNGFRAU HILL

Shuts off water to upper Jungfrau

Shuts off water to Eiger

Area to be


Area to be



WASATCH COUNTY	INTERLAKEN MUTAL WATER COMPANY	2003 WATERLINE IMPROVEMENTS RECORD DRAWINGS- JUNGFRAU HILL	SOWBY & BERG CONSULTANTS 45 N. 490 W. #92-1277 AMERICAN FORK, UTAH 84003	SCALE: 1" = 50'	DESIGN BY: SES DRAWN BY: RDB	DATE: 06 APR 2003 REV: 23 NOV 2004	DRAWING NAME: W09	SHEET NO: W9
----------------	--------------------------------	--	--	--------------------	---------------------------------	---------------------------------------	----------------------	-----------------



WASATCH COUNTY INTERLAKEN MUTAL WATER COMPANY 2003 WATERLINE IMPROVEMENTS RECORD DRAWINGS- JUNGFRAU HILL SOWBY & BERG CONSULTANTS SCALE: 1" = 50' DESIGN BY: SES DATE: 06 APR 2003 SHEET NO. W9A
 DRAWN BY: RDB REV: 23 NOV 2004 DRAWING NAME: W09A 45 N. 490 W. 492-1277 AMERICAN FORK, UTAH 84003

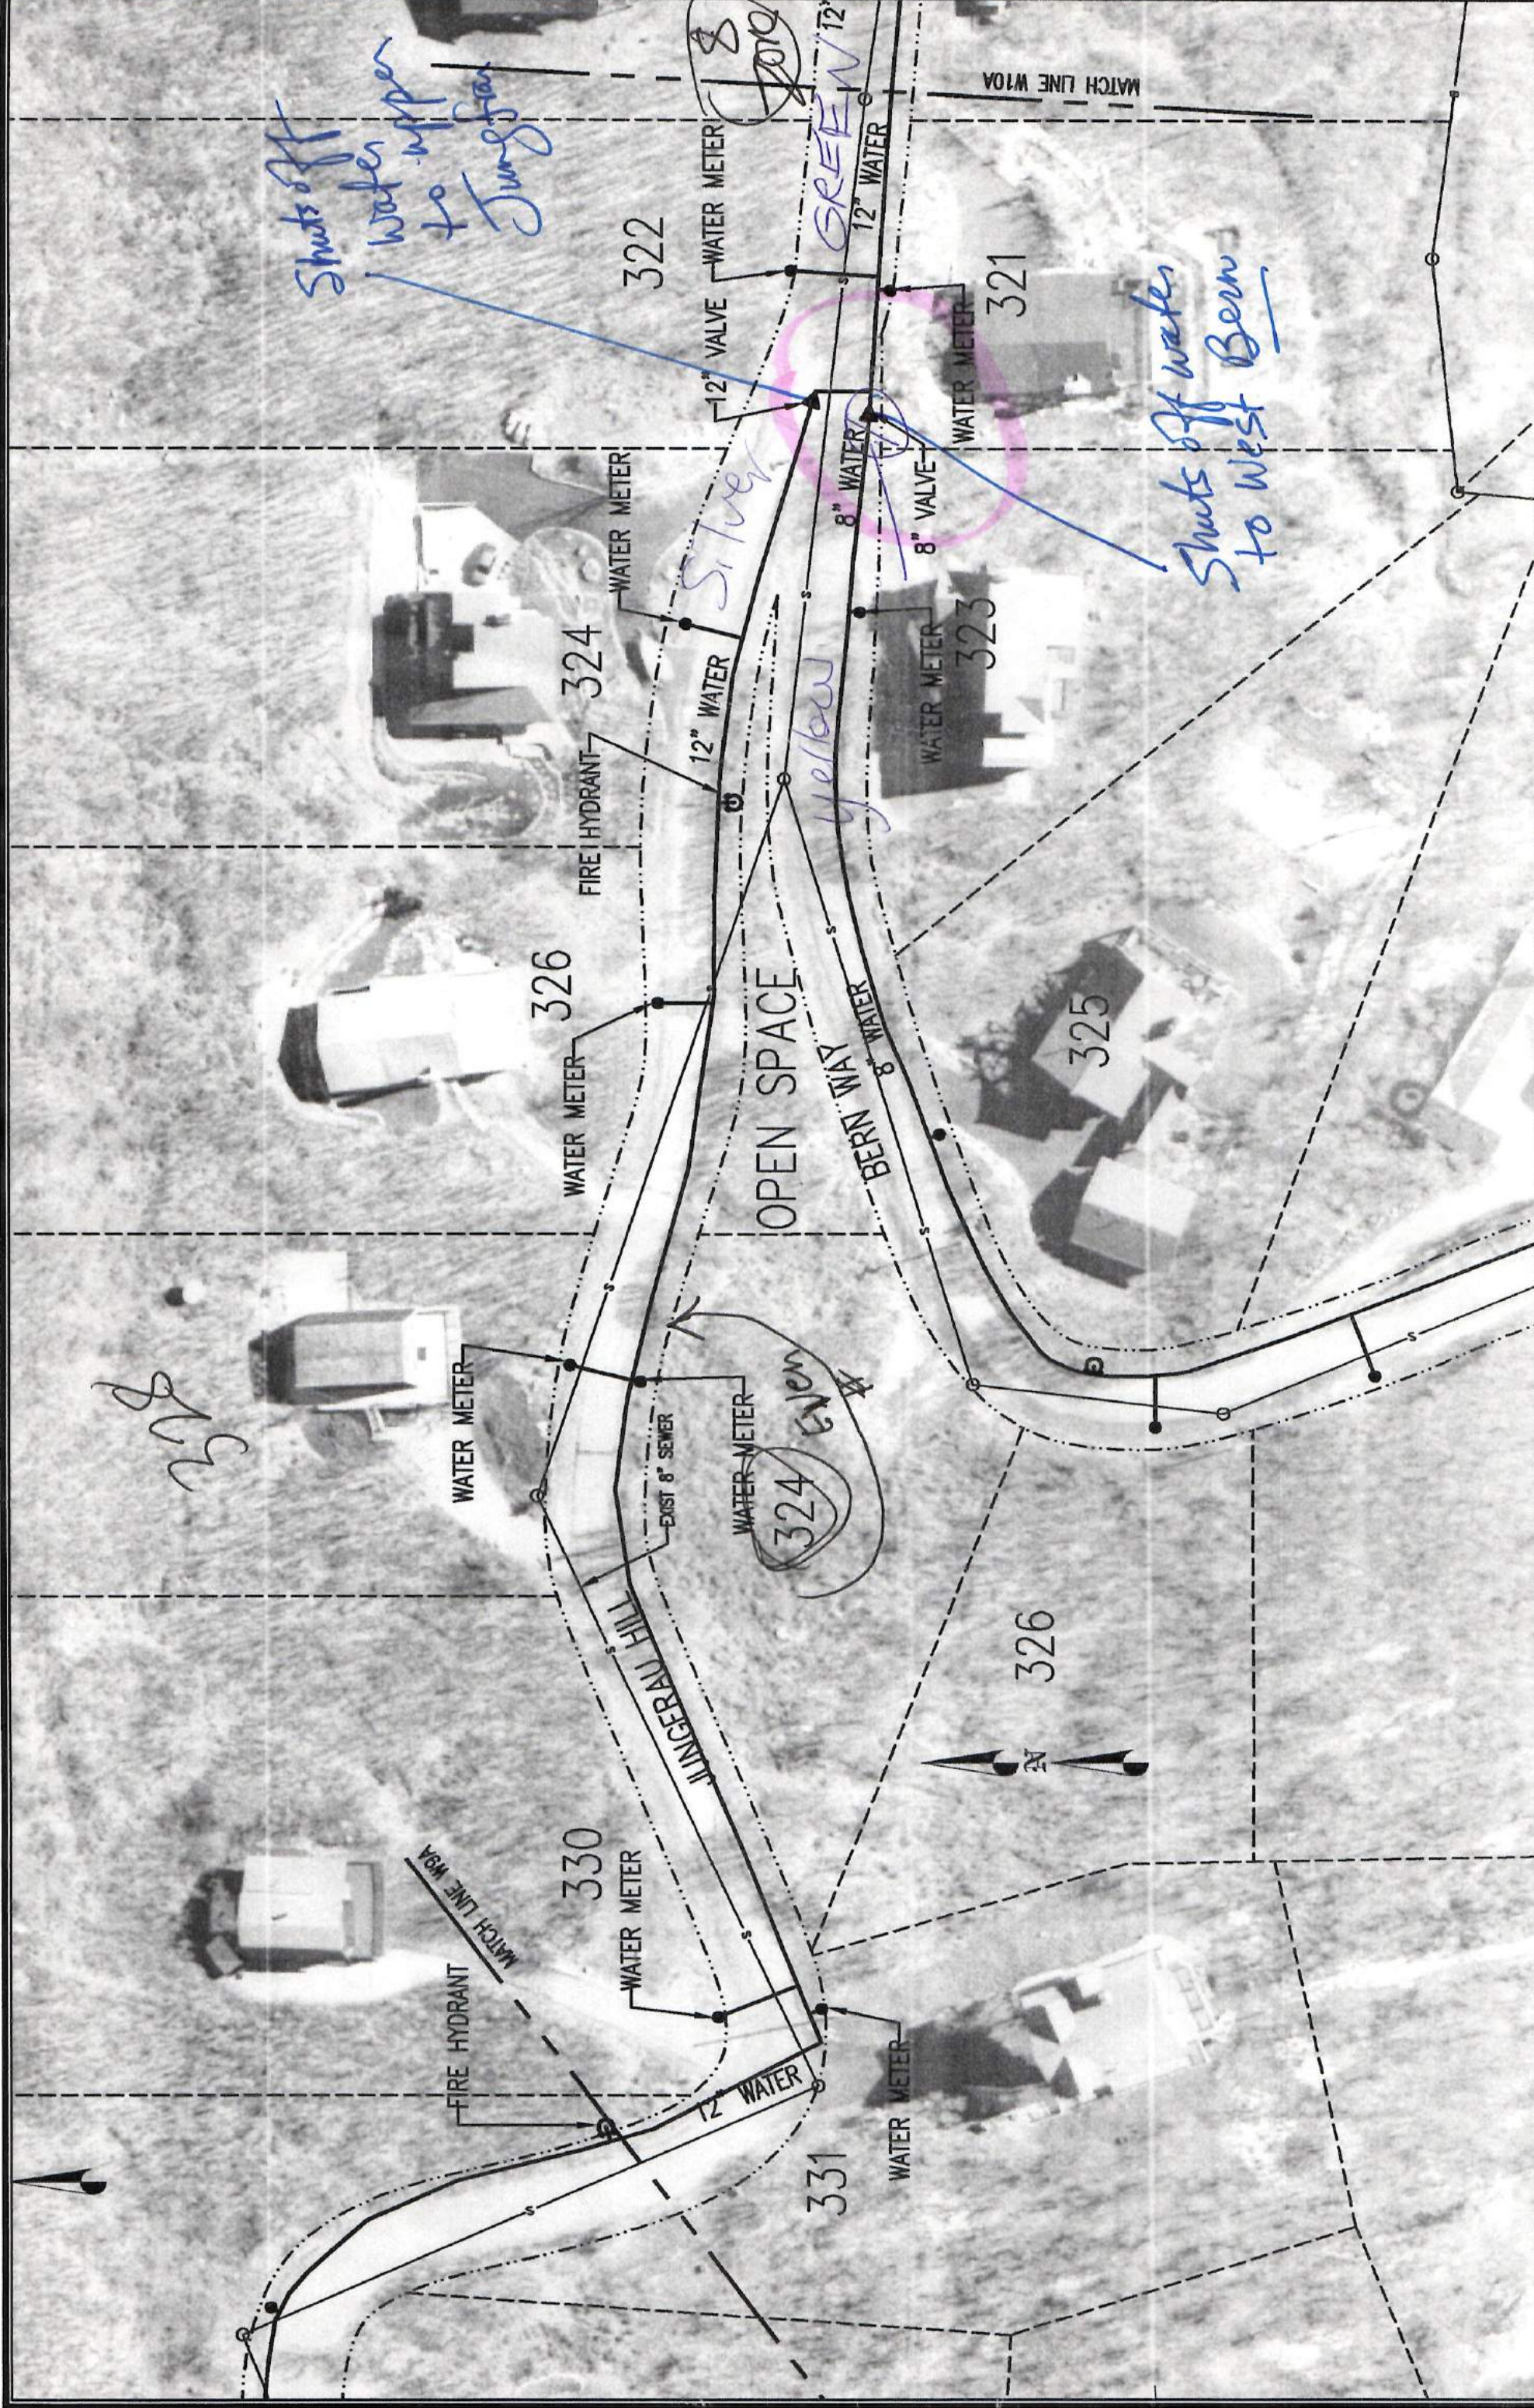

Shuts off water to upper Jungfrau

2010

Silver


yellow

Shuts off water to West Bern

326

324 even

WASATCH COUNTY	INTERLAKEN MUTAL WATER COMPANY	2003 WATERLINE IMPROVEMENTS RECORD DRAWINGS- JUNGFRAU HILL	SOWBY & BERG CONSULTANTS 45 N. 490 W. #92-1277 AMERICAN FORK, UTAH 84003	SCALE: 1" = 50'	DESIGN BY: SES DRAWN BY: RDB	DATE: 06 APR 2003 REV: 23 NOV 2004	DRAWING NAME: W10	SHEET NO. W10
----------------	--------------------------------	--	--	--------------------	---------------------------------	---------------------------------------	----------------------	------------------

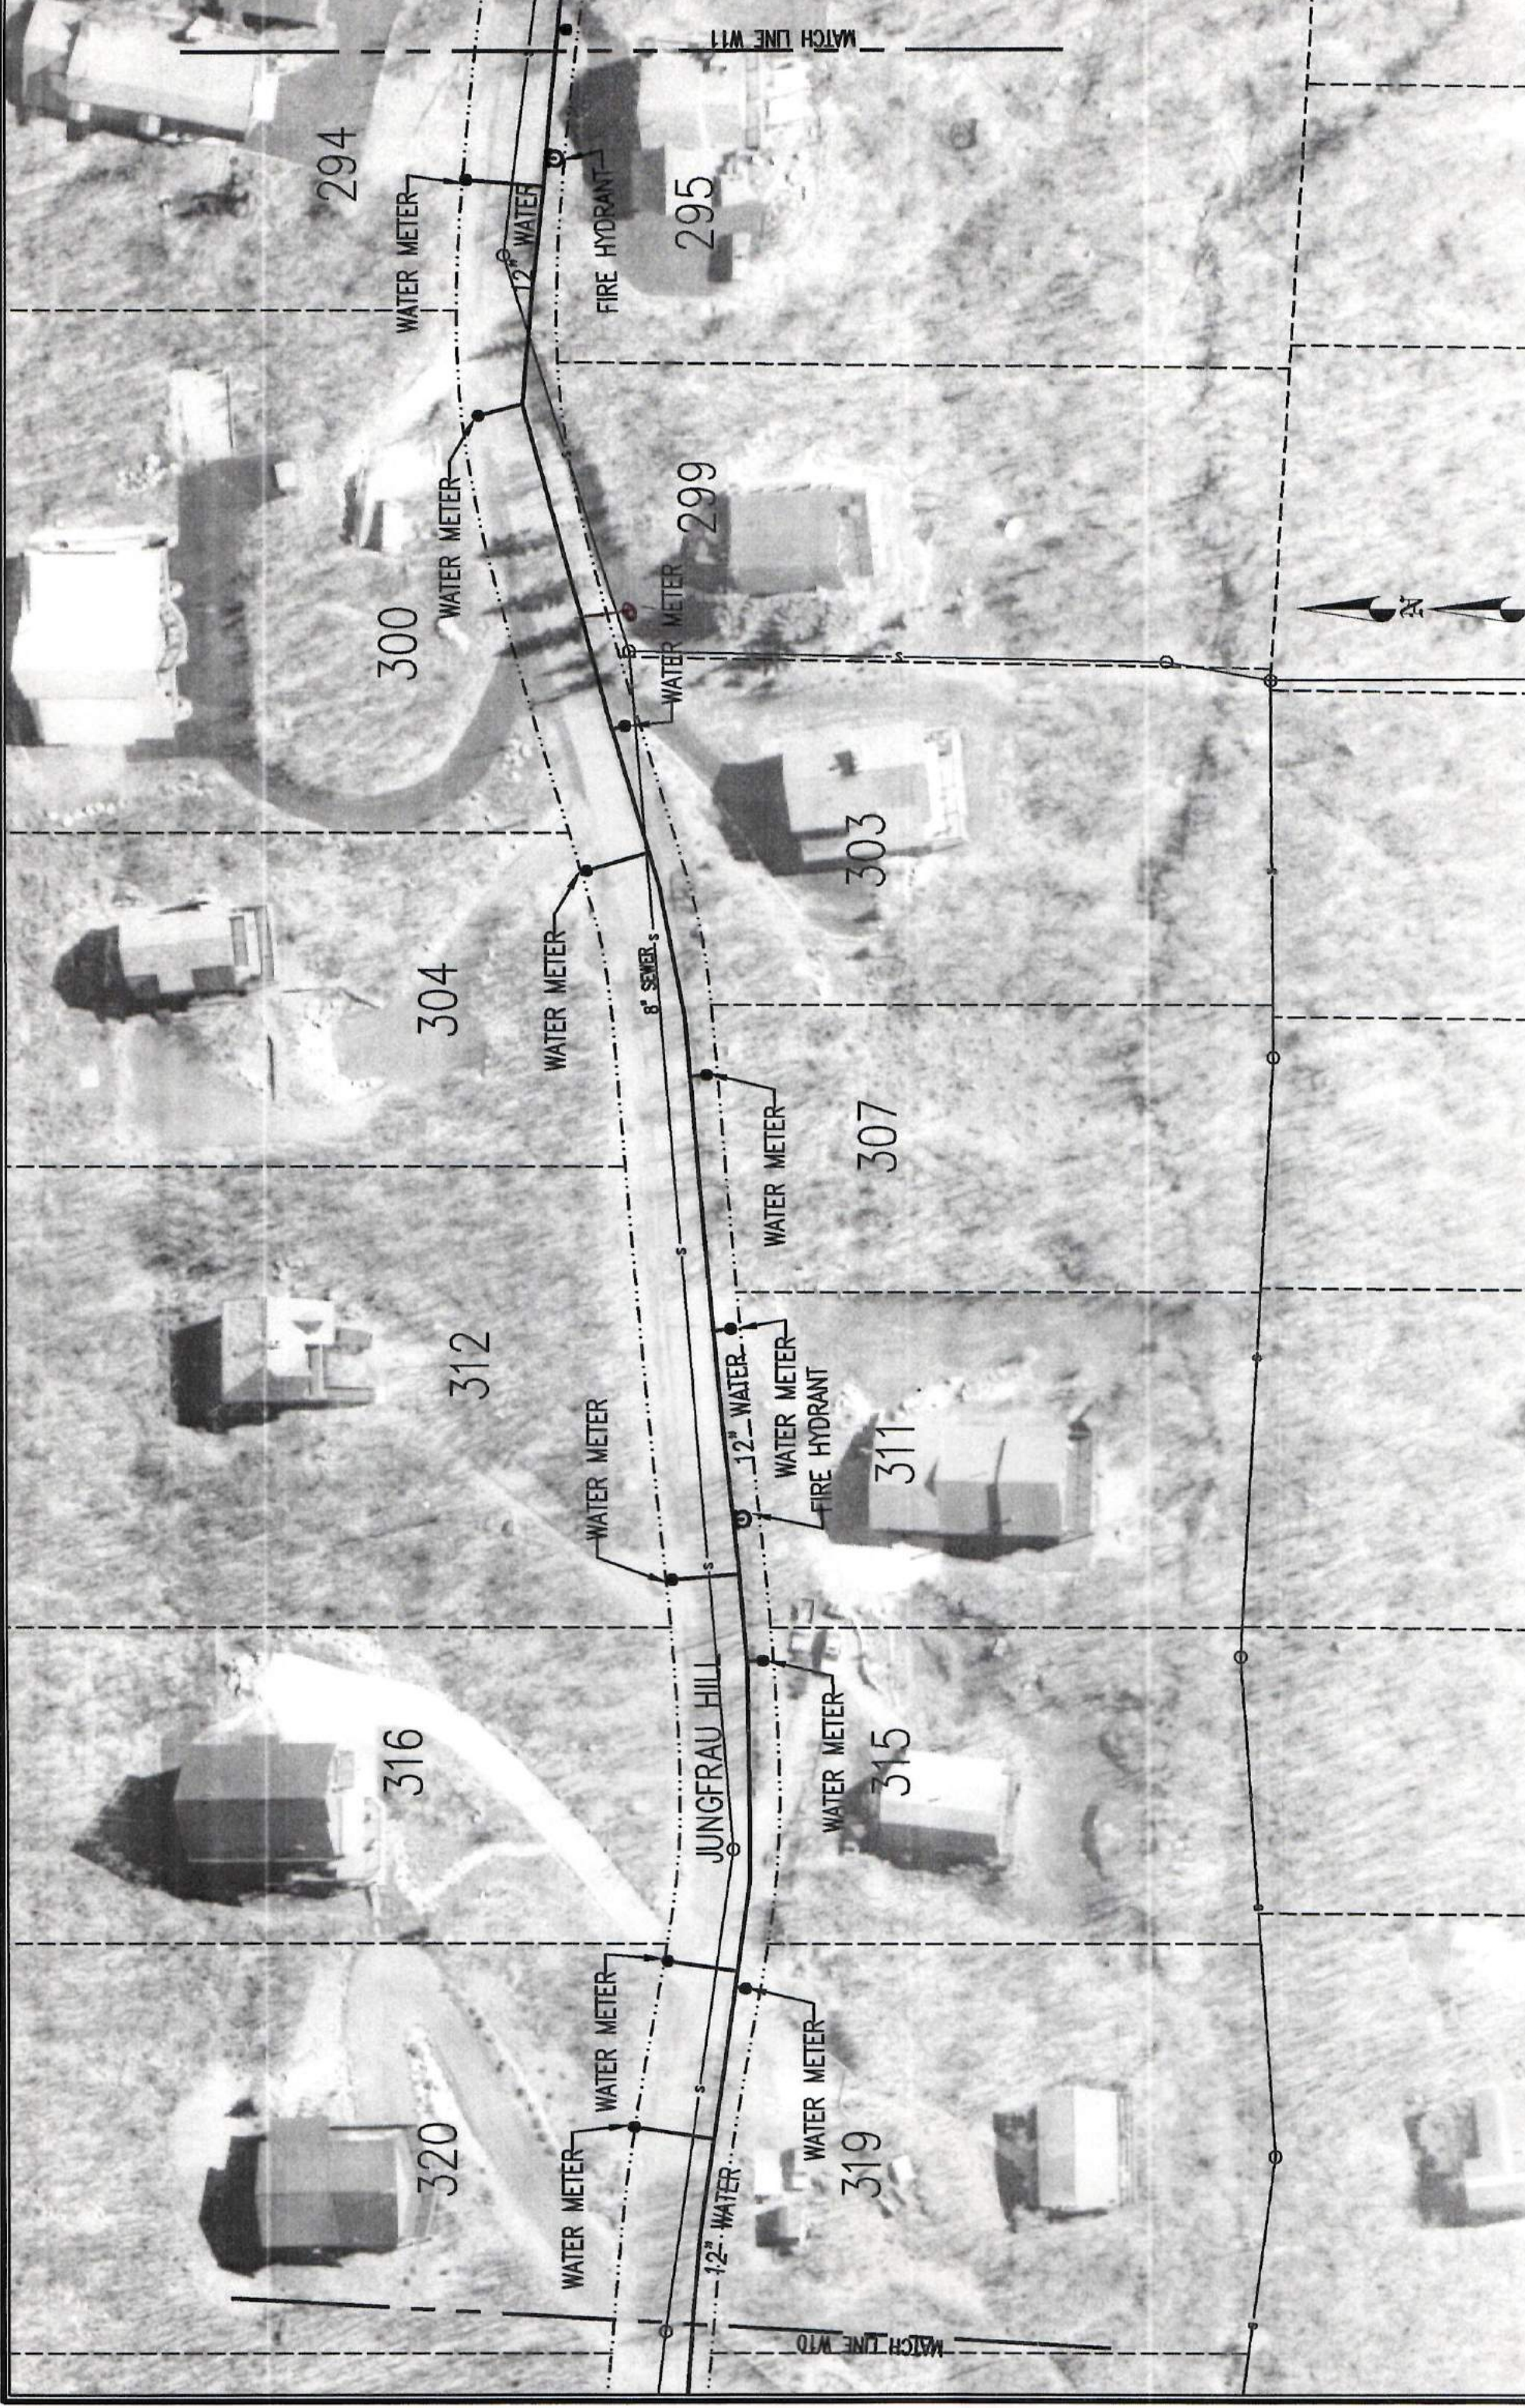


MATCH LINE W11


MATCH LINE W10

WASATCH COUNTY	INTERLAKEN MUTAL WATER COMPANY	2003 WATERLINE IMPROVEMENTS RECORD DRAWINGS- JUNGFRAU HILL	SOWBY & BEPC CONSULTANTS 15 N. 400 W. 402-1277 AMERICAN FORK, UTAH 84003	SCALE: 1" = 50'	DESIGN BY: SES DRAWN BY: RDB	DATE: 06 APR 2003 REV: 23 NOV 2004	DRAWING NAME: W10A	SHEET NO: W10A
----------------	--------------------------------	--	--	--------------------	---------------------------------	---------------------------------------	-----------------------	-------------------



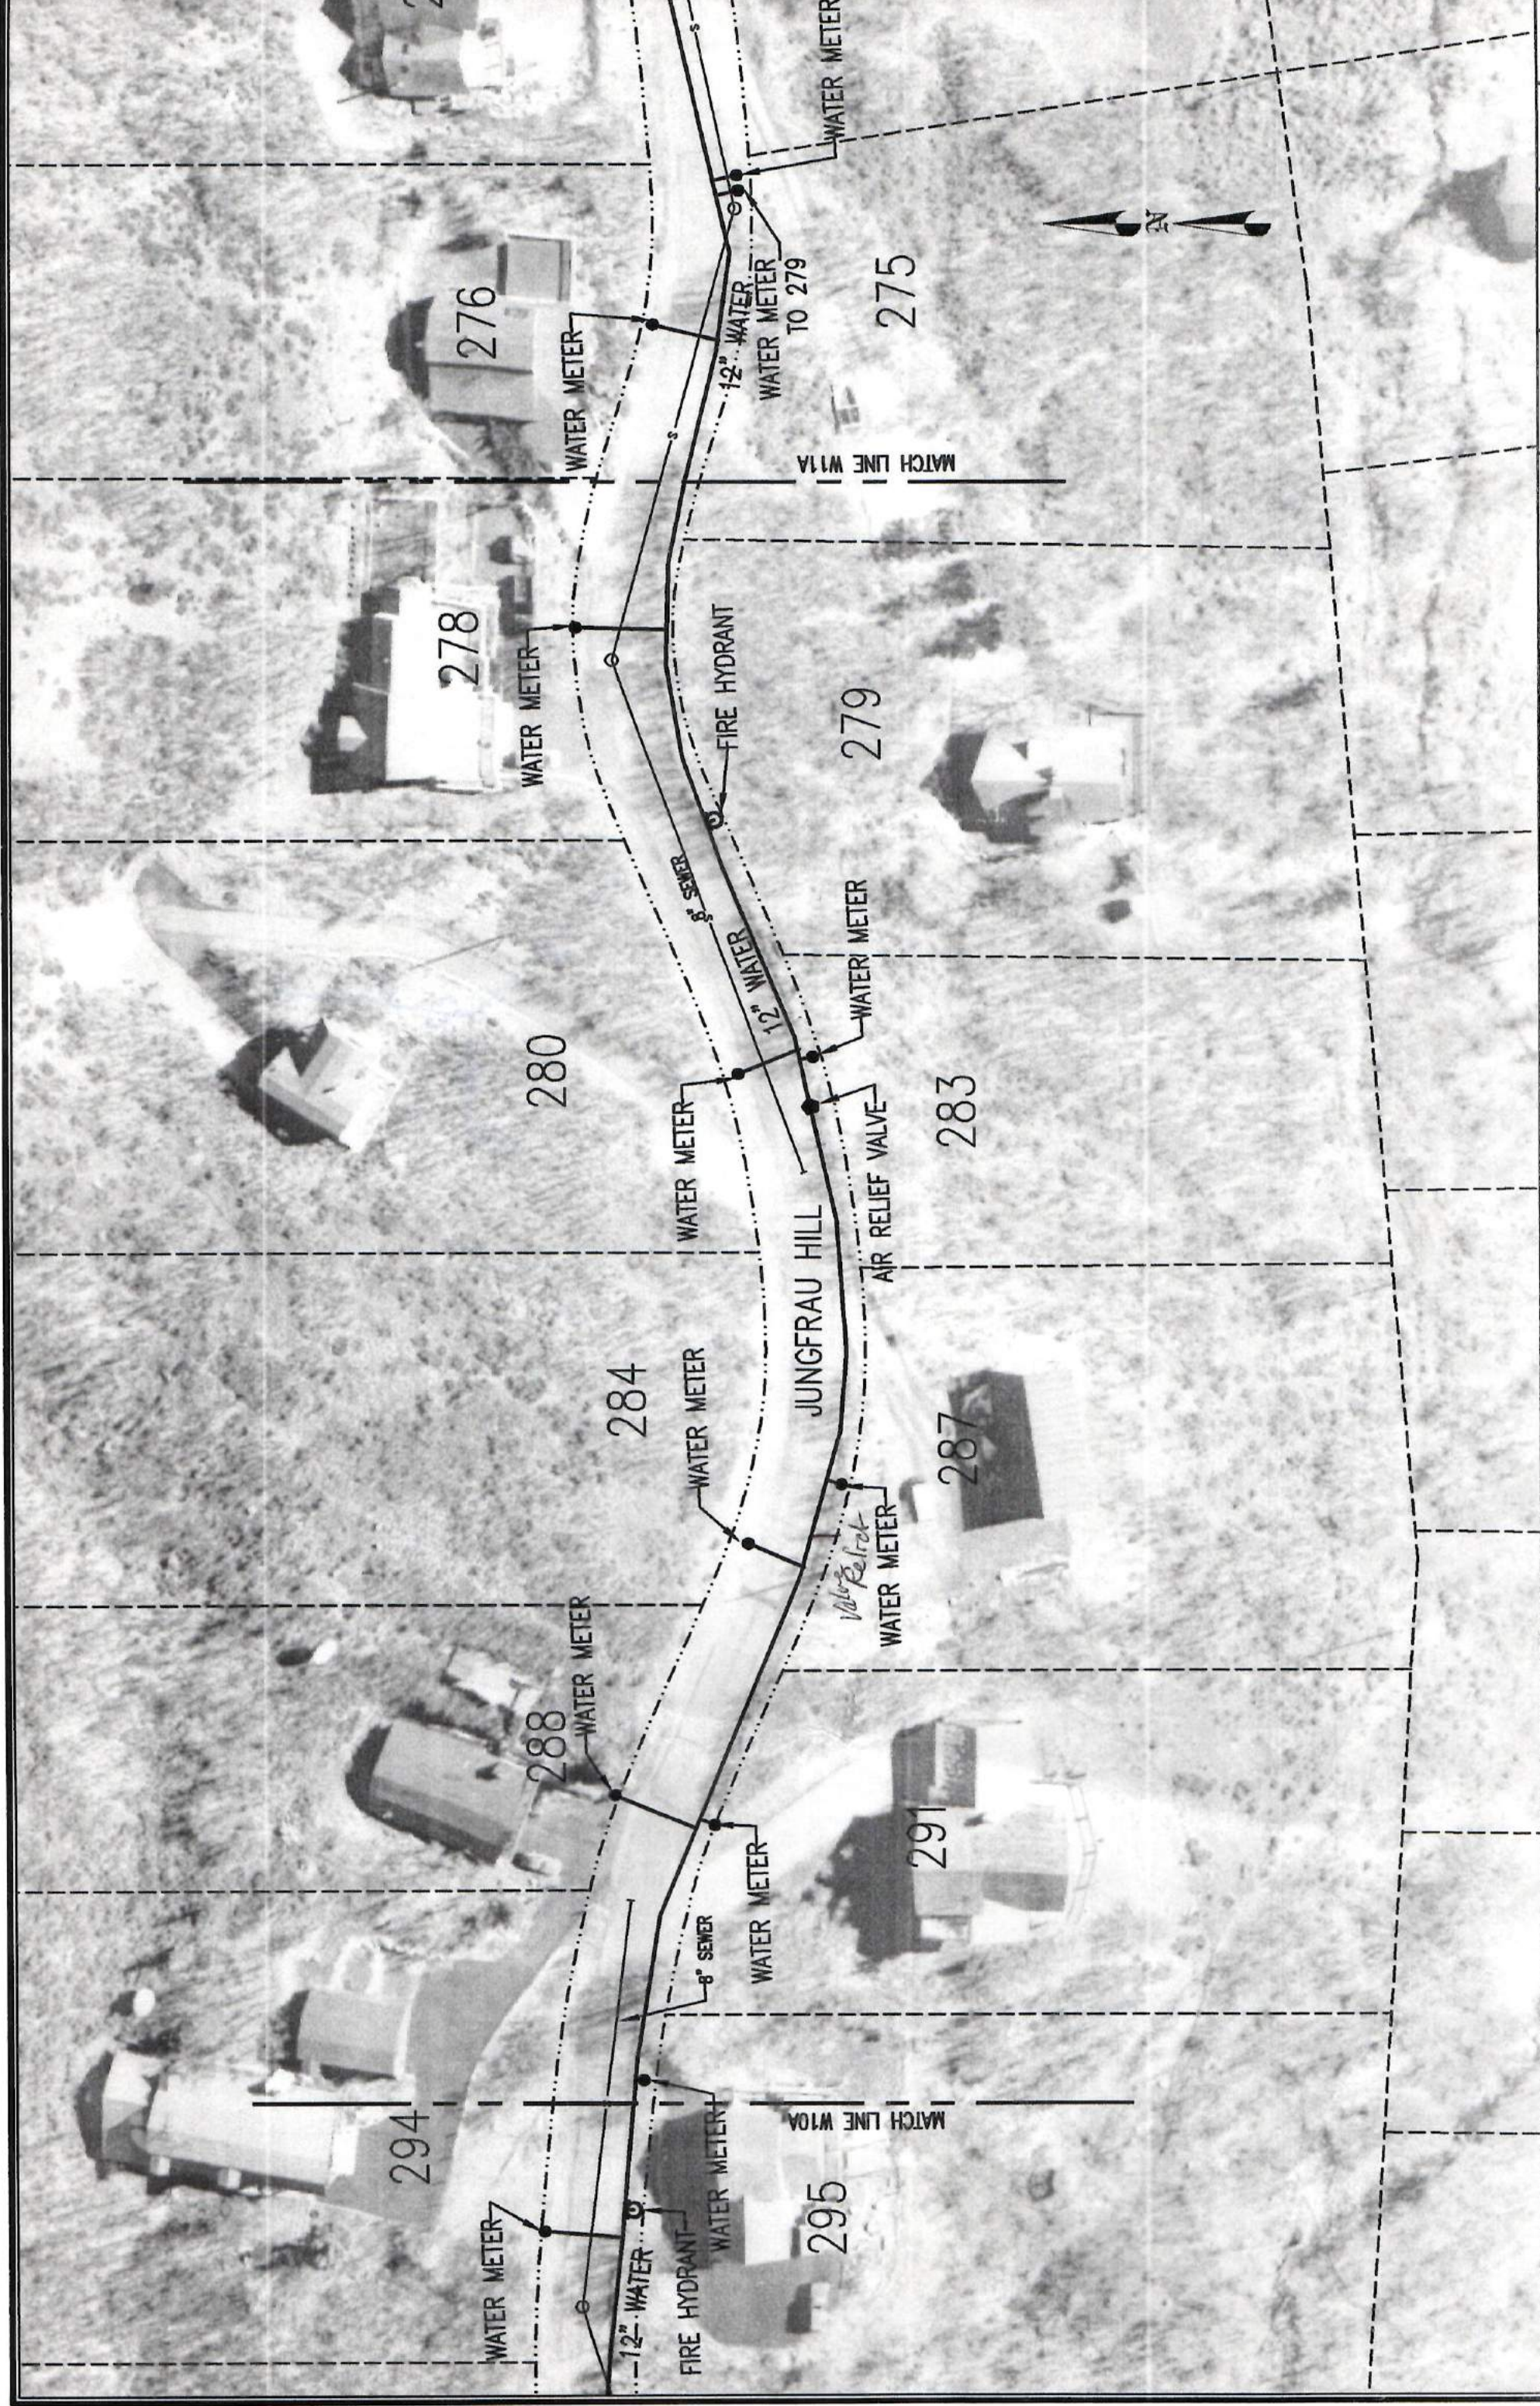

WASATCH COUNTY
 INTERLAKEN MUTAL WATER COMPANY
 2003 WATERLINE IMPROVEMENTS RECORD DRAWINGS - JUNGFRAU HILL
 SOWBY & BERG CONSULTANTS
 45 N. 490 W. 492-1277
 AMERICAN FORK, UTAH 84003
 SCALE: 1" = 50'
 DESIGN BY: SES DATE: 06 APR 2003
 DRAWN BY: RDB REV: 23 NOV 2004
 DRAWING NAME: W11
 SHEET NO: W11

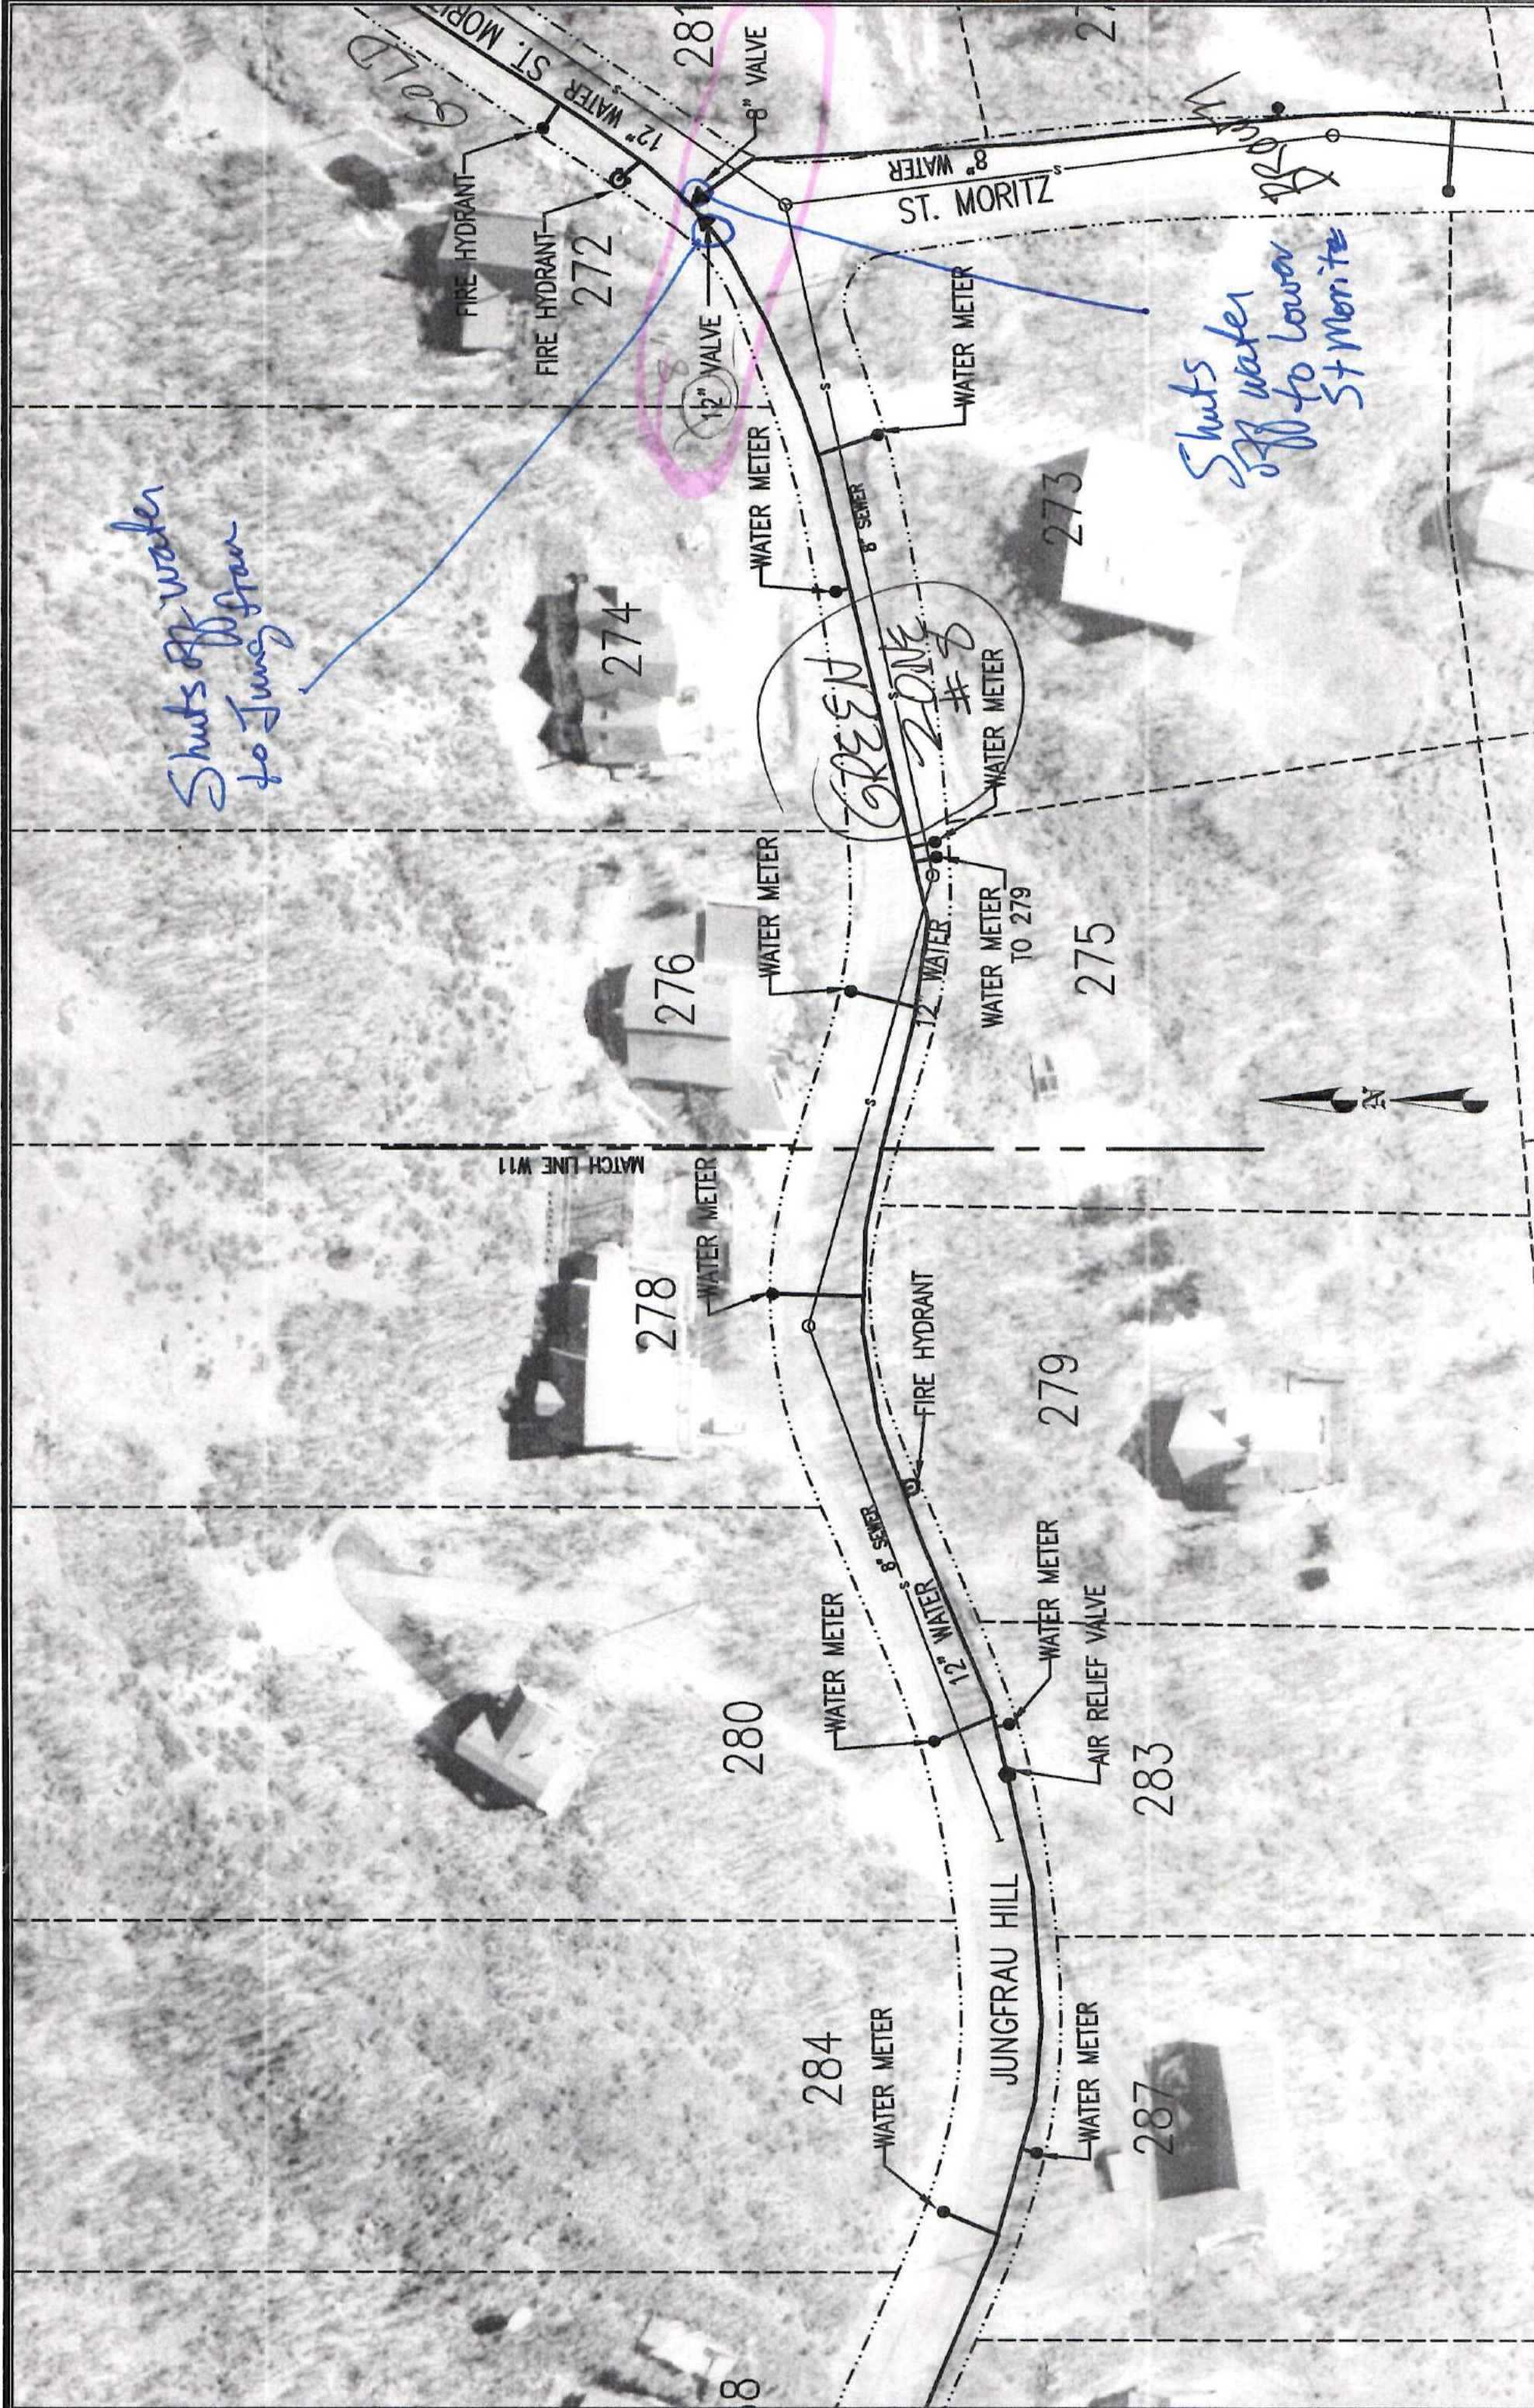


Shuts off water to Jungfrau Hill

Shuts off water to lower St Moritz

GREEN ZONE #8


WASATCH COUNTY	INTERLAKEN MUTAL WATER COMPANY	2003 WATERLINE IMPROVEMENTS RECORD DRAWINGS - JUNGFRAU HILL	SOWBY & BERG CONSULTANTS 45 N. 490 W. 492-1277 AMERICAN FORK, UTAH 84003	SCALE: 1" = 50'	DESIGN BY: SES DATE: 06 APR 2003 DRAWN BY: RDB REV: 23 NOV 2004	DRAWING NAME: WHA	SHEET NO: W11A
----------------	--------------------------------	---	--	--------------------	--	----------------------	-------------------

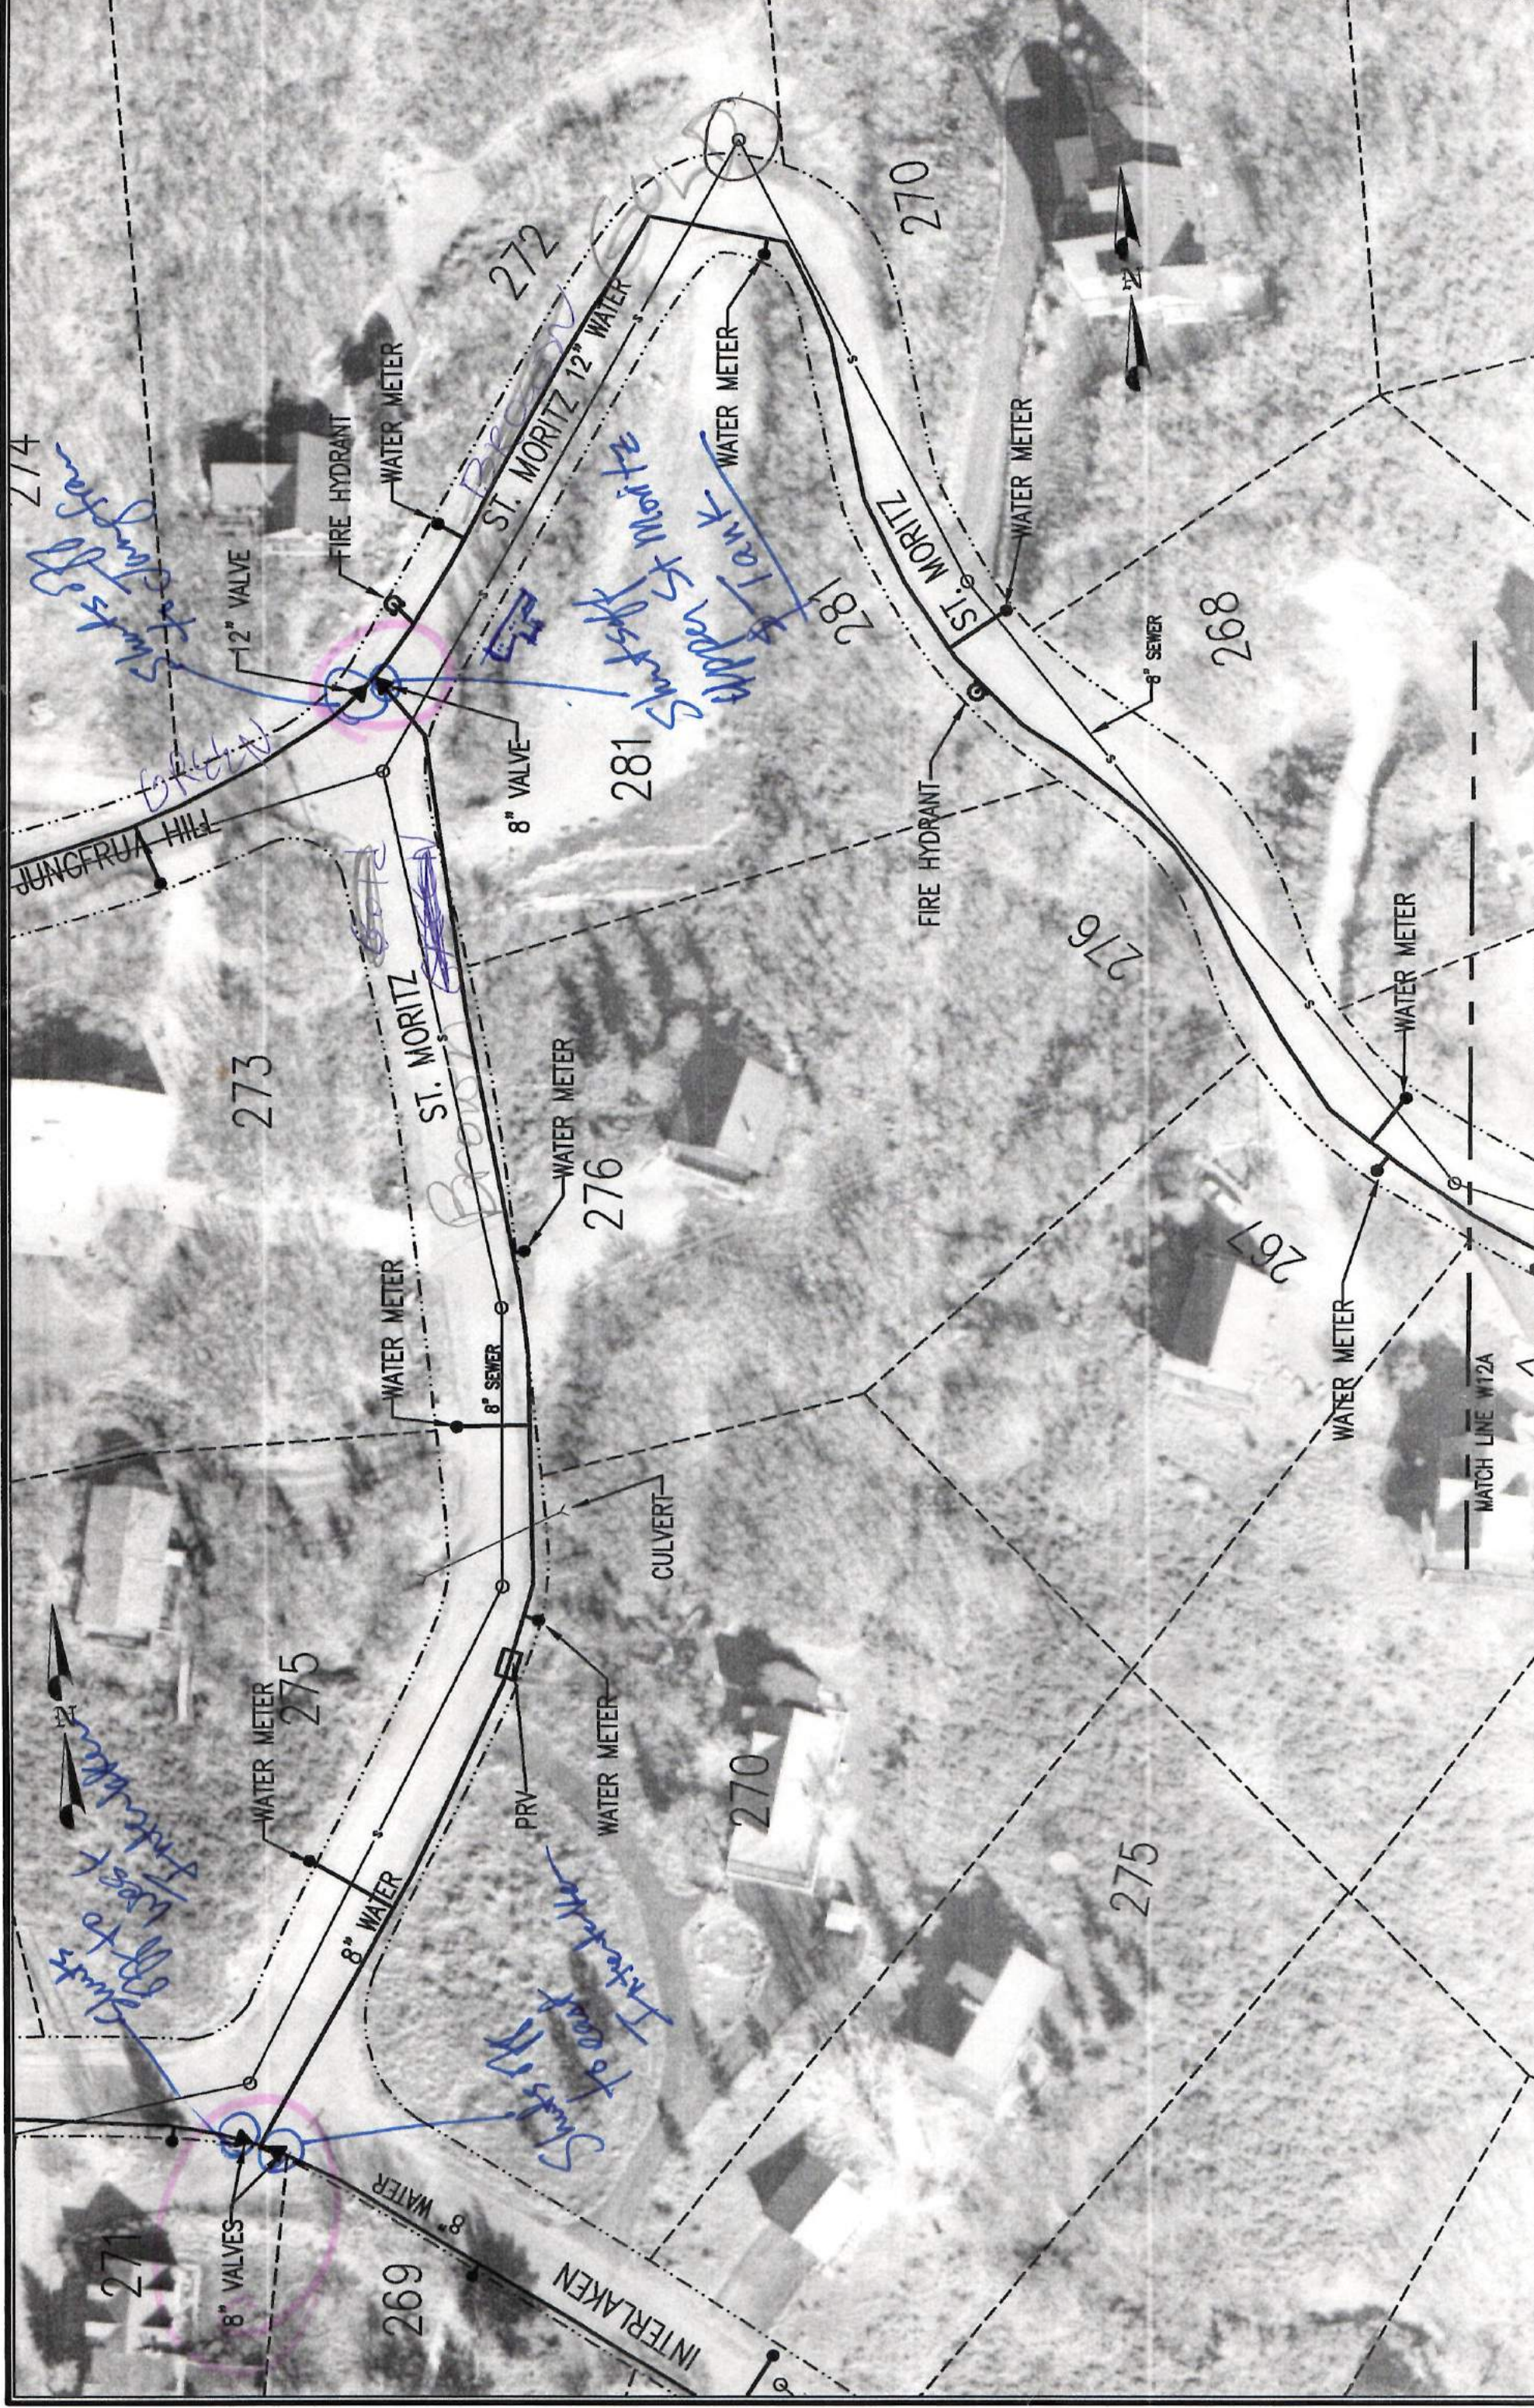


St. Moritz Tank
St. Moritz 12" Water
St. Moritz 12" Water

St. Moritz Tank
St. Moritz 12" Water

WASATCH COUNTY	INTERLAKEN MUTAL WATER COMPANY	2003 WATERLINE IMPROVEMENTS RECORD DRAWINGS- ST. MORITZ	SOWBY & BERG CONSULTANTS 45 N. 490 W. #492-1277 AMERICAN FORK, UTAH 84003	SCALE: 1" = 50'	DESIGN BY: SGS DRAWN BY: RDB	DATE: 06 APR 2003 REV: 23 NOV 2004	DRAWING NAME: W12	SHEET NO: W12
----------------	--------------------------------	---	---	--------------------	---------------------------------	---------------------------------------	----------------------	------------------

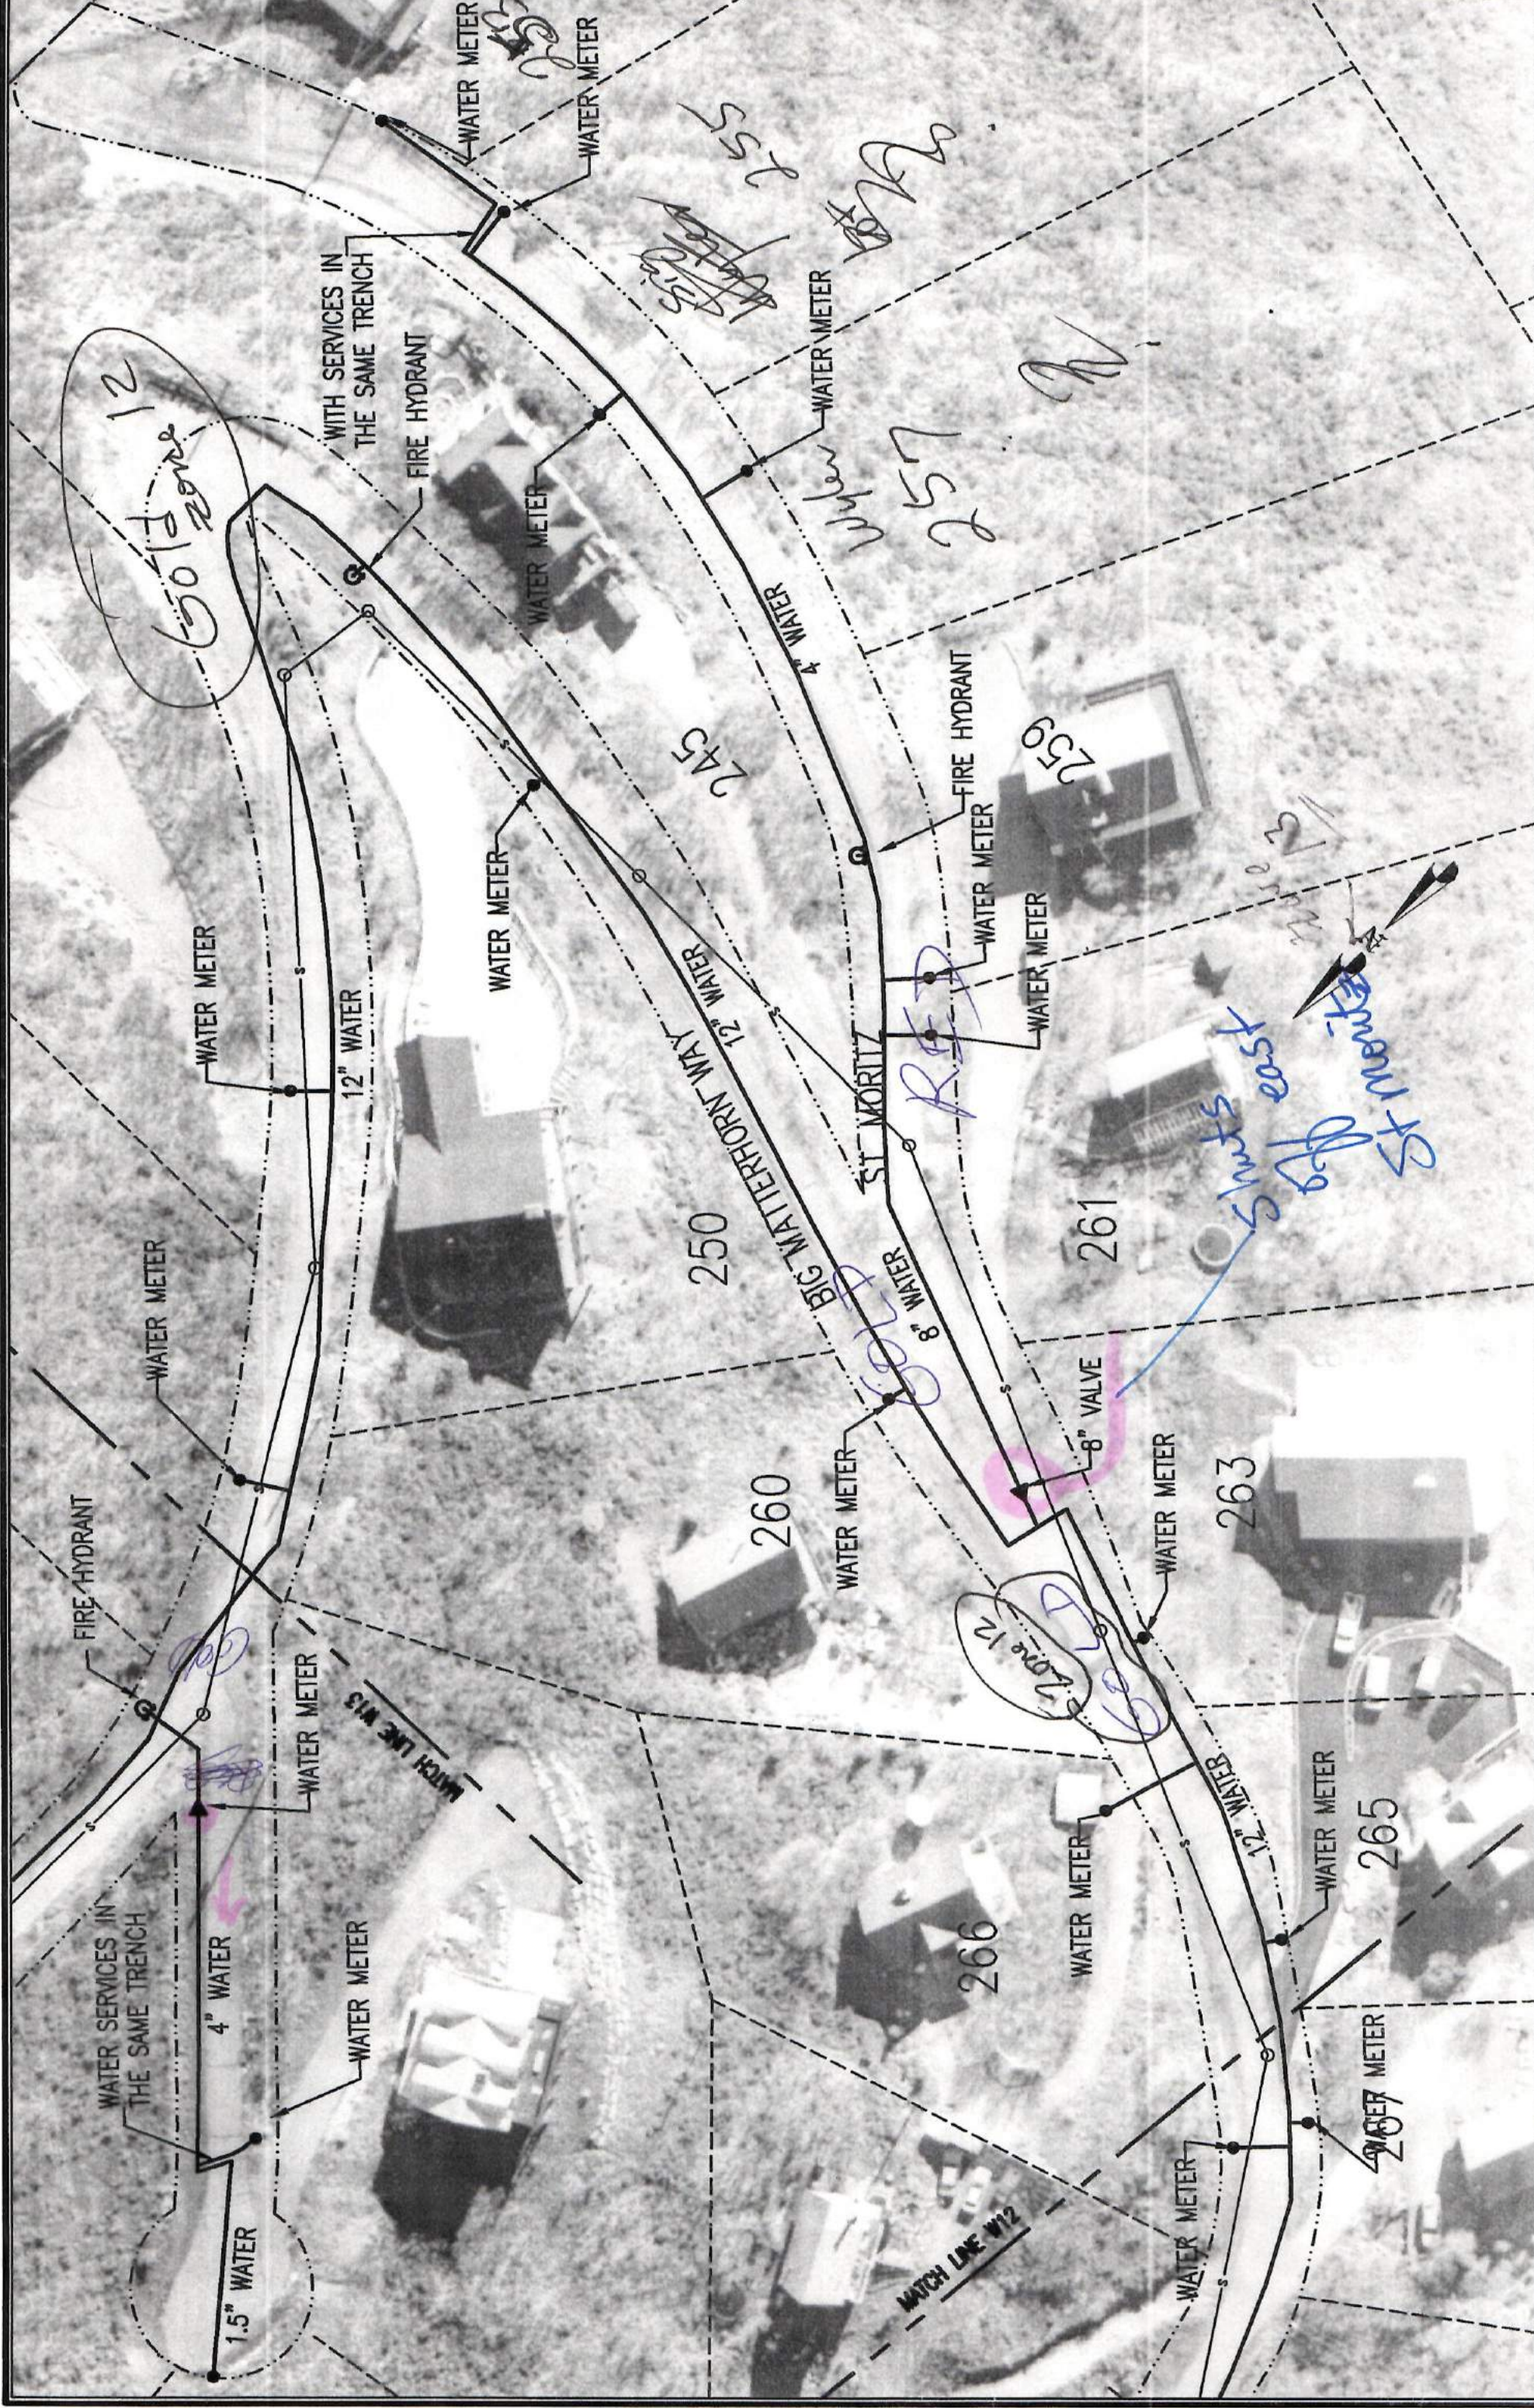

WASATCH COUNTY	INTERLAKEN MUTAL WATER COMPANY	2003 WATERLINE IMPROVEMENTS RECORD DRAWINGS - ST. MORITZ	SOWBY & BERG CONSULTANTS 45 N. 490 W. #92-1277 AMERICAN FORK, UTAH 84003	SCALE: 1" = 50'	DESIGN BY: SES DRAWN BY: RDB	DATE: 06 APR 2003 REV: 23 NOV 2004	DRAWING NAME: W12A	SHEET NO. W12A
----------------	--------------------------------	--	--	--------------------	---------------------------------	---------------------------------------	-----------------------	-------------------

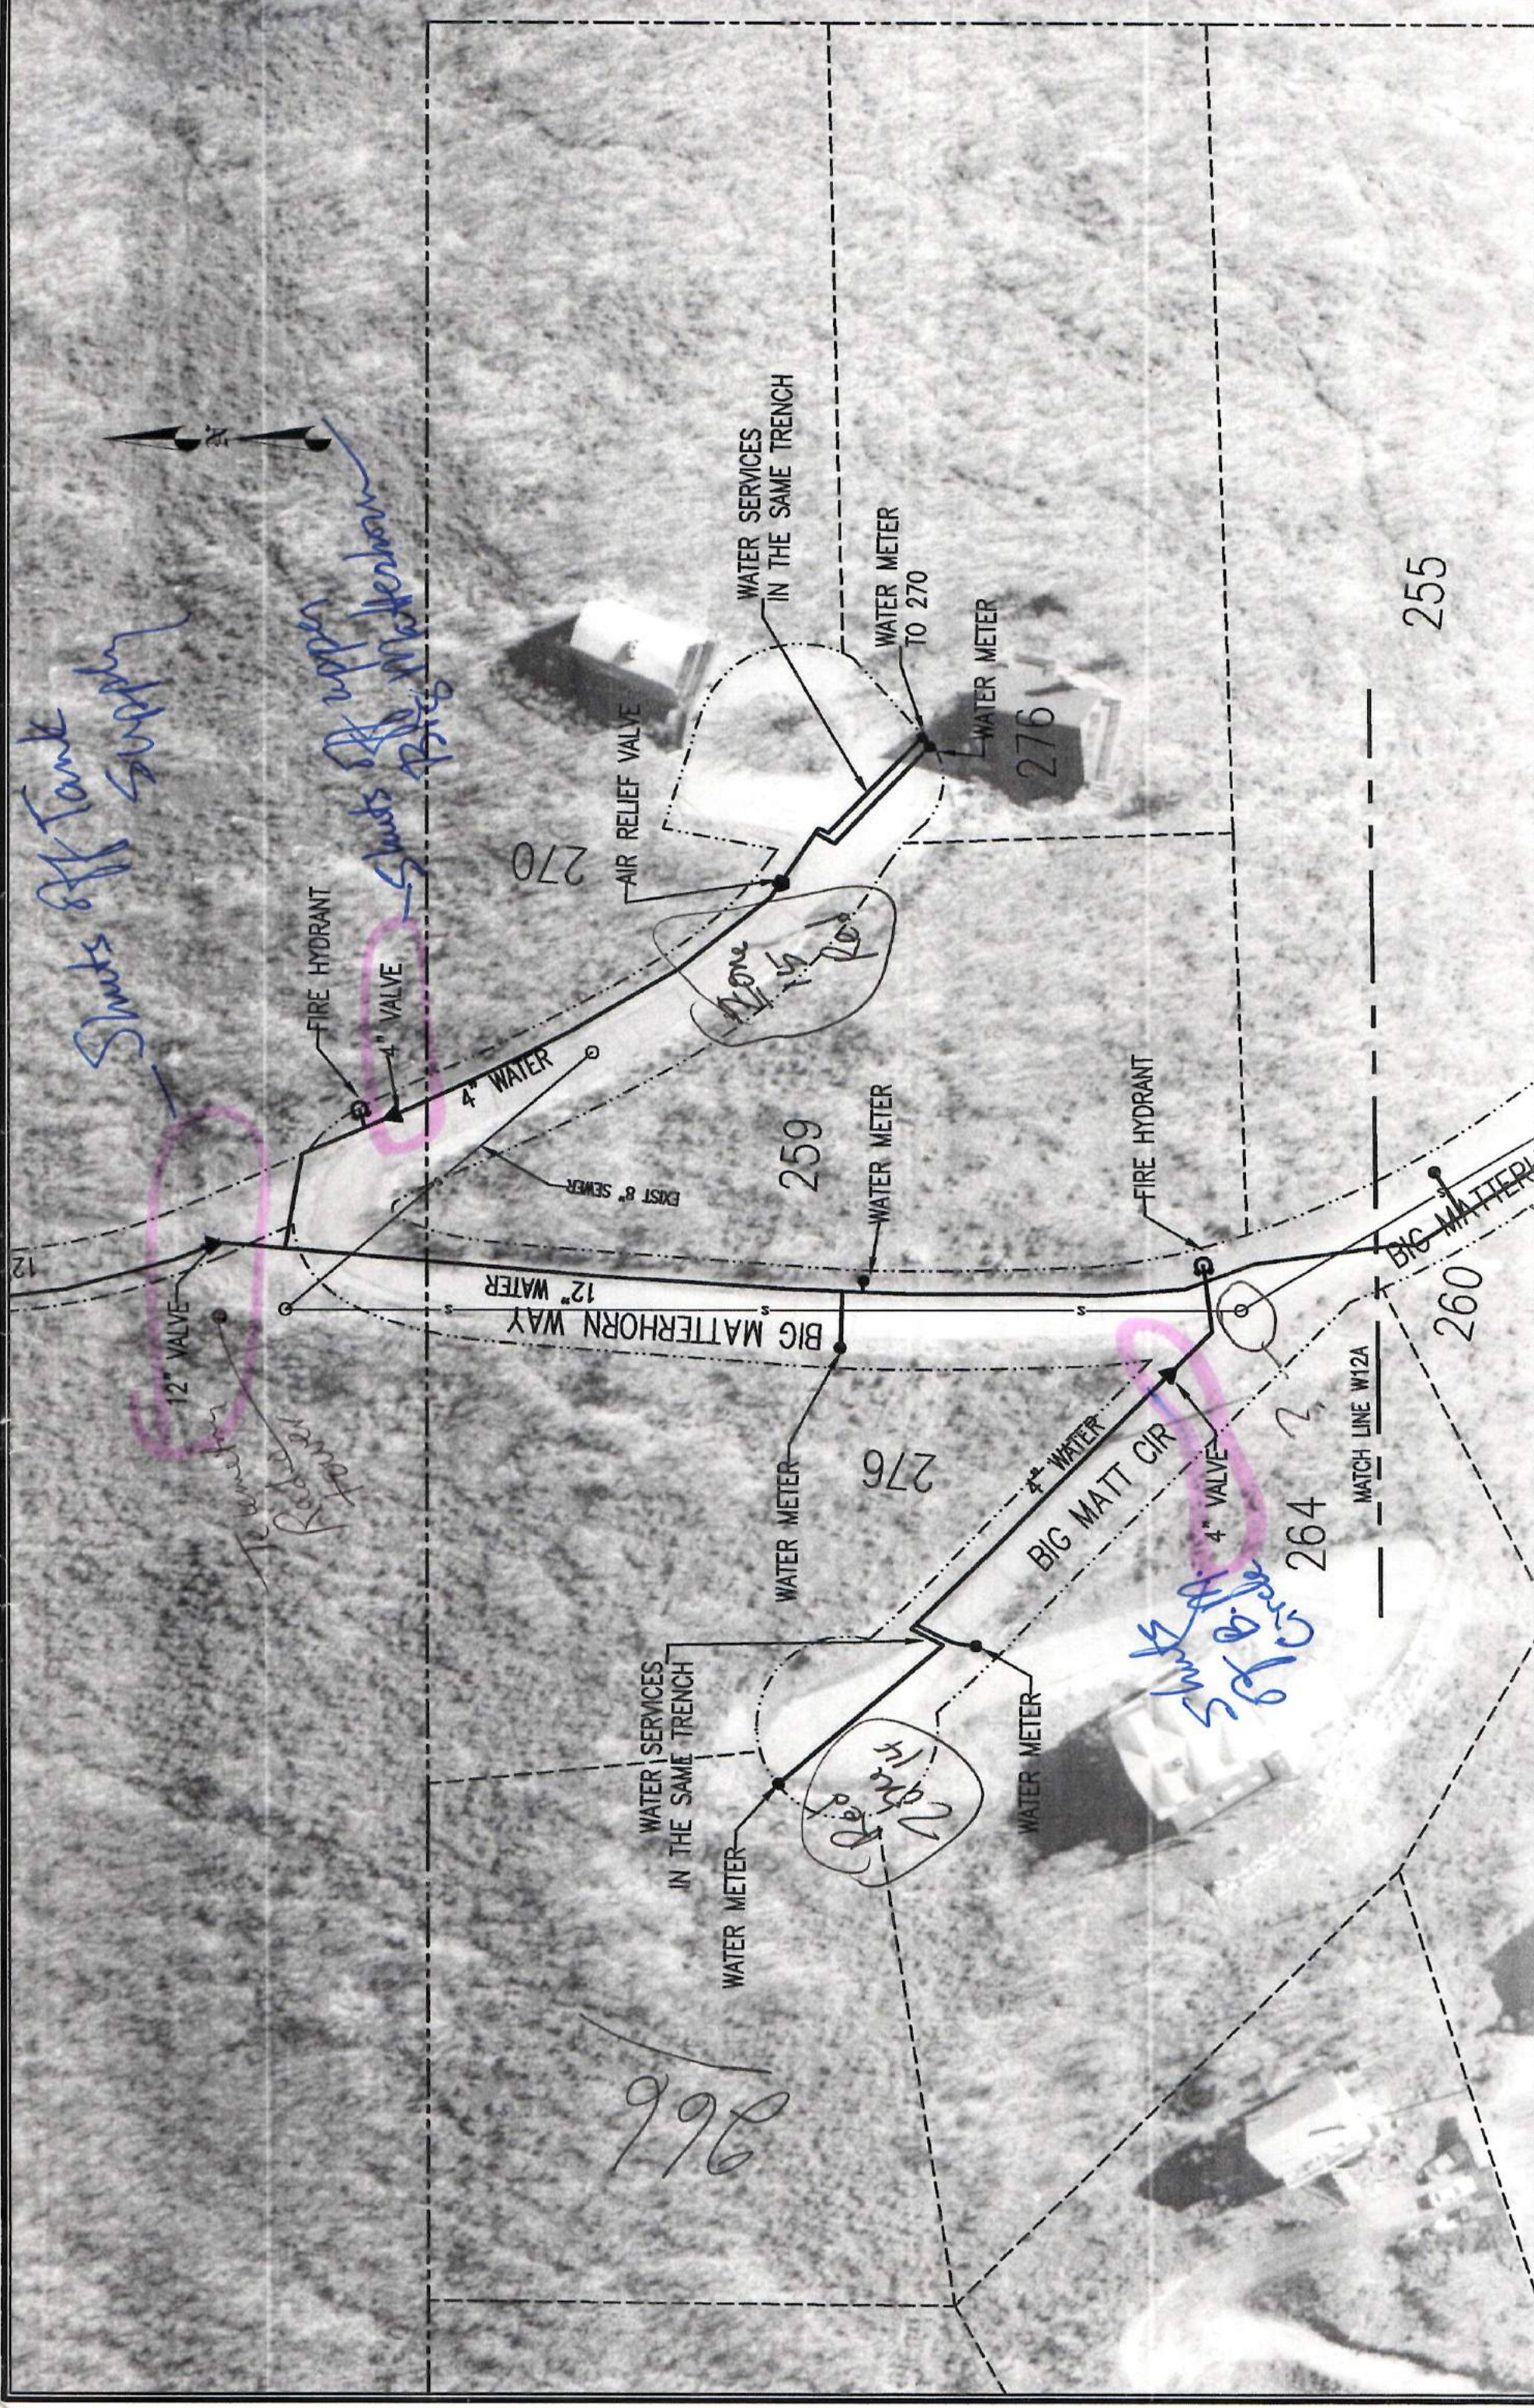

Shuts off Tank Supply

Shuts off upper Big Matterhorn

Shuts off Tank Supply


Shuts off Big Matterhorn

996

None 15 10

None 15 10

WASATCH COUNTY	INTERLAKEN MUTAL WATER COMPANY	2003 WATERLINE IMPROVEMENTS RECORD DRAWINGS- BIG MATTERHORN WAY	SOWBY & BERG CONSULTANTS 45 N. 490 W. 492-1277 AMERICAN FORK, UTAH 84003	SCALE: 1" = 50'	DESIGN BY: SES DRAWN BY: RDB	DATE: 06 APR 2003 REV: 23 NOV 2004	DRAWING NAME: W13	SHEET NO. W13
----------------	--------------------------------	---	--	--------------------	---------------------------------	---------------------------------------	----------------------	------------------

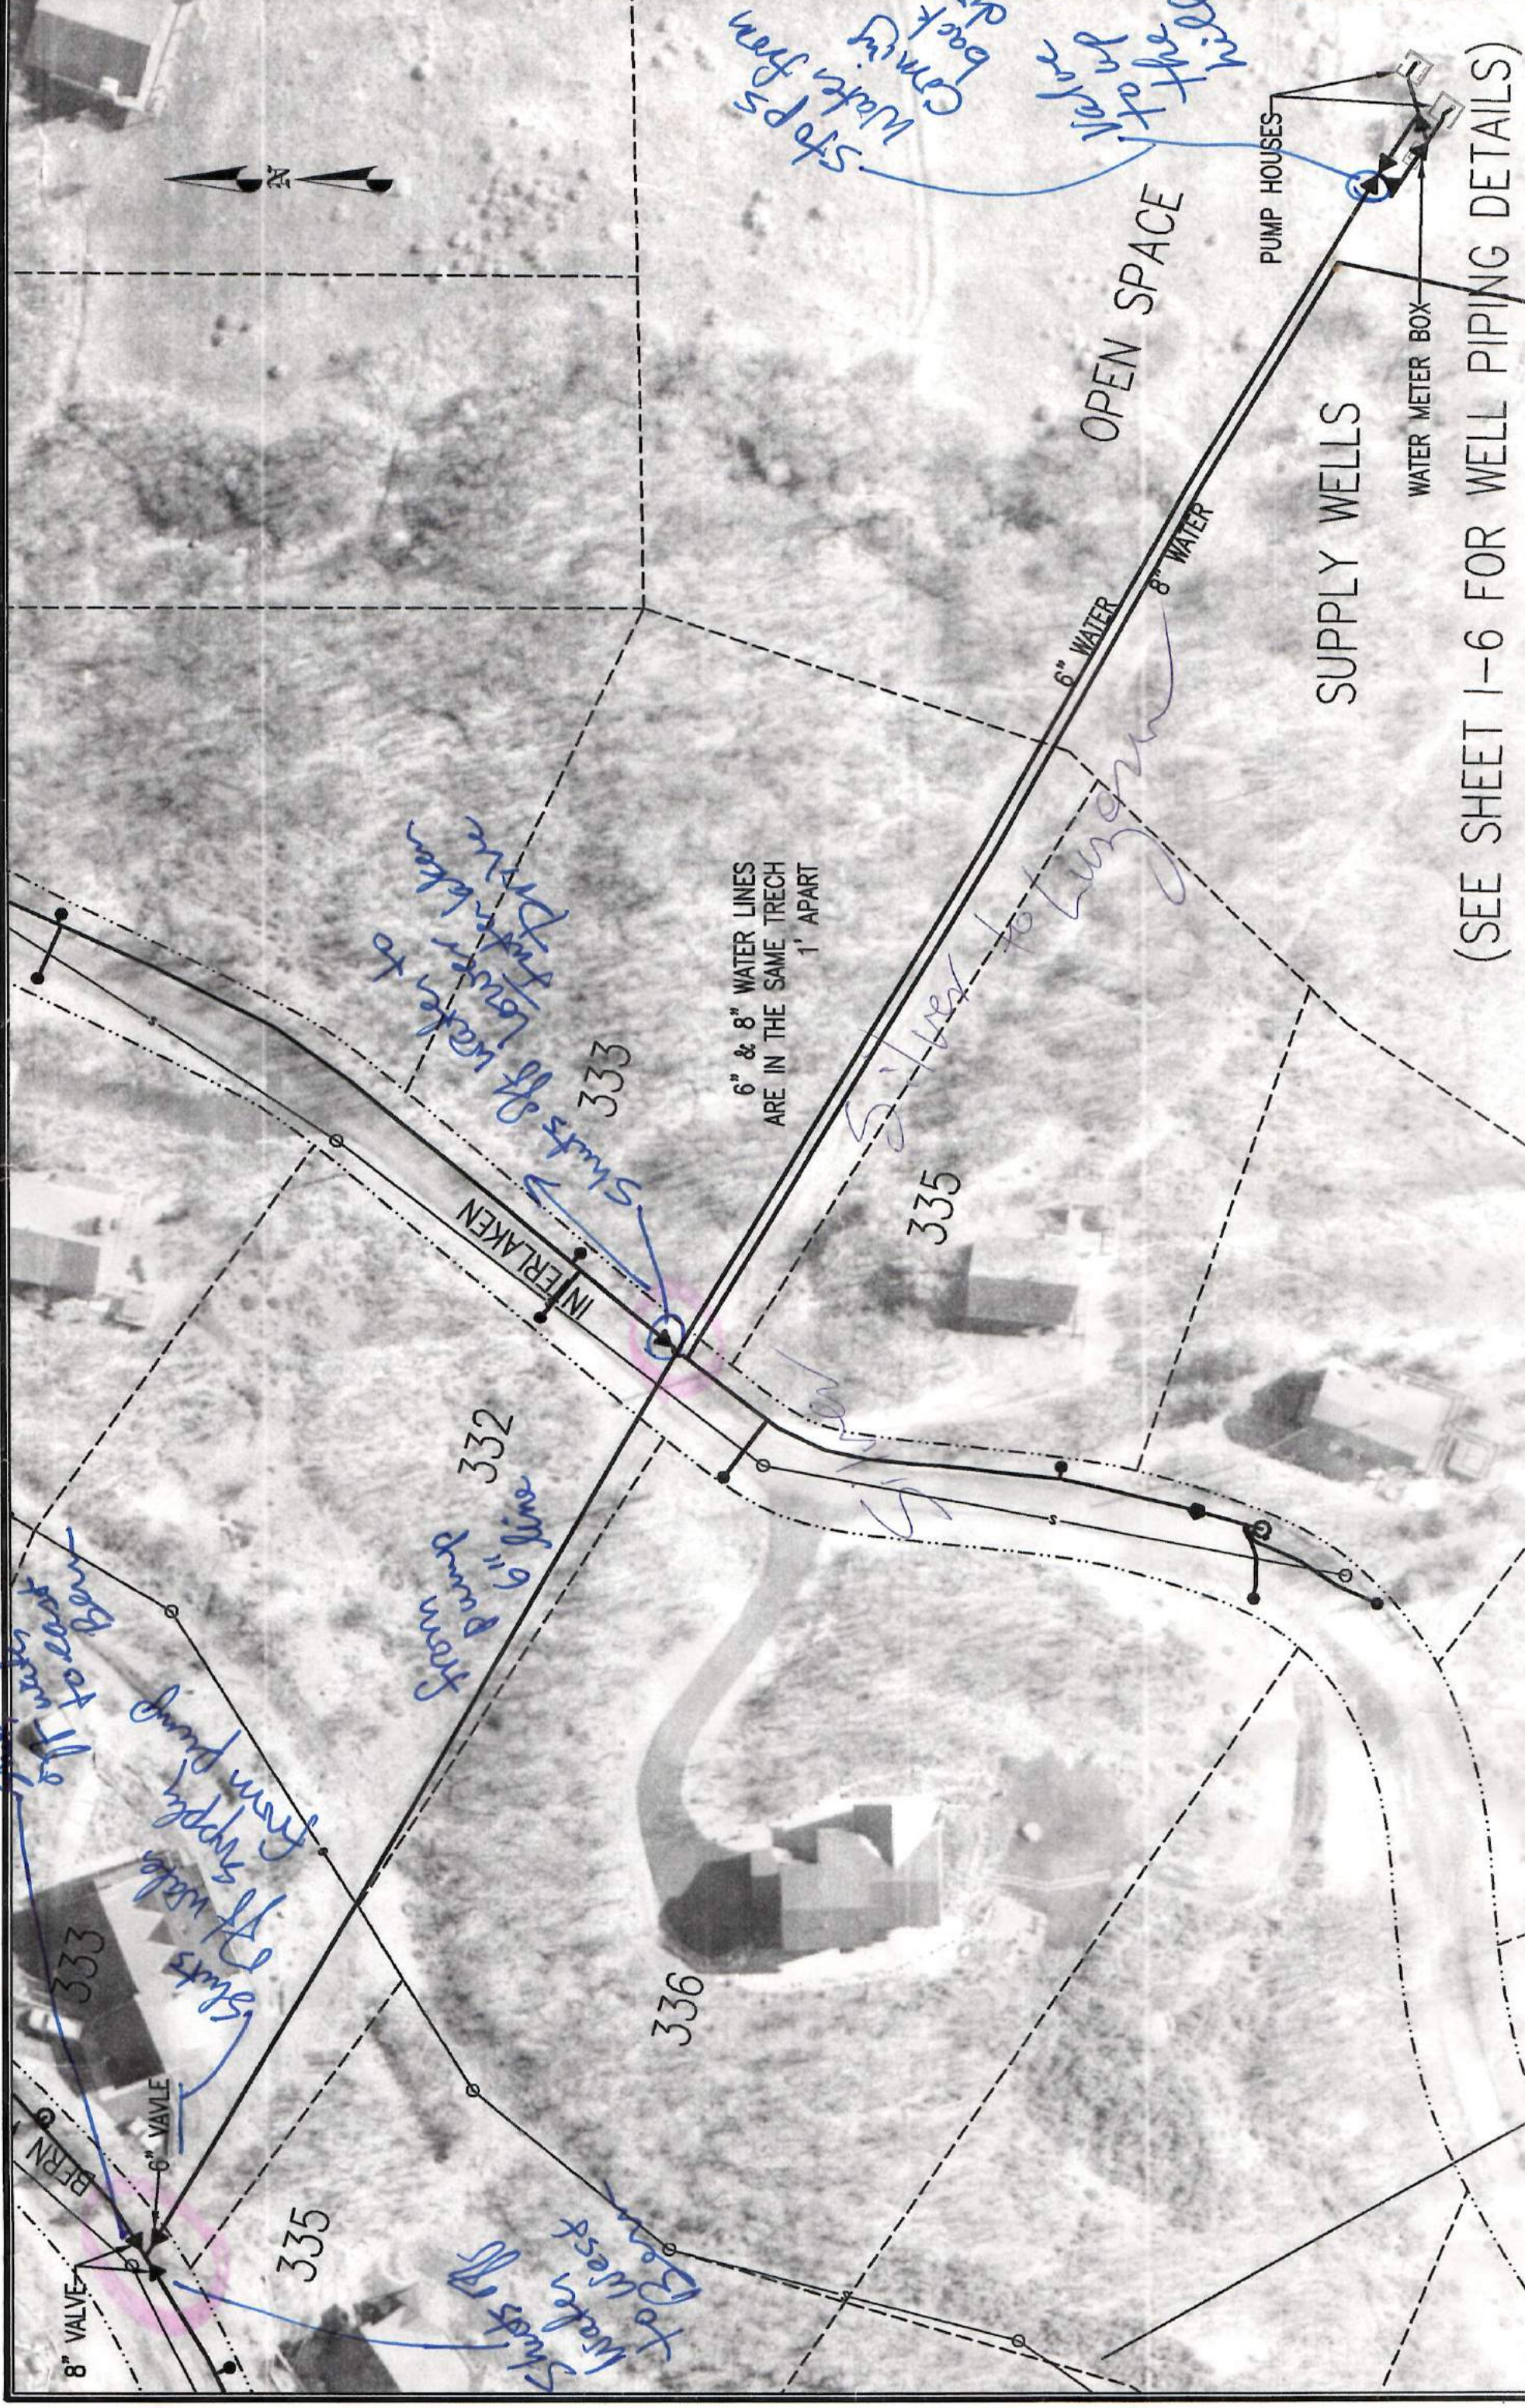

(SEE SHEET 1-6 FOR WELL PIPING DETAILS)

WASATCH COUNTY	INTERLAKEN MUTAL WATER COMPANY	2003 WATERLINE IMPROVEMENTS RECORD DRAWINGS- WELL DISCHARGE LINES	SOWBY & BERG CONSULTANTS 15 N. 450 W. AMERICAN FORK, UTAH 84003	SCALE: 1" = 50'	DESIGN BY: SES DRAWN BY: RDB	DATE: 06 APR 2003 REV: 23 NOV 2004	DRAWING NAME: 714	SHEET NO. W14
----------------	--------------------------------	---	---	--------------------	---------------------------------	---------------------------------------	----------------------	------------------